

STATE OF KANSAS
STATE CORPORATION COMMISSION

WELL PLUGGING RECORD

Give All Information Completely
Make Required Affidavit
Mail or Deliver Report to
Conservation Division
State Corporation Comm.
245 North Water
Wichita, KS 67202

Graham County. Sec. 4 Twp. 9S Rge. 25 E/W
Location as "NE/CNW/SW" or footage from lines
SE, NW SW

Lease Owner The Maurice L. Brown Co.
Lease Name KNOLL Well No. 1
Office Address 1500 Vickers KSB&T Bldg.

Character of Well (Completed as Oil, Gas or Dry Hole)
Dry Hole


Date Well completed August 7 1976
Application for plugging filed (verbally) August 7 1976
Application for plugging approved (verbally) August 7 1976
Plugging commenced August 7 1976
Plugging completed August 7 1976

Reason for abandonment of well or producing formation
No commercial quantity of oil or gas encountered.

If a producing well is abandoned, date of last production
19

Was permission obtained from the Conservation Division or
its agents before plugging was commenced? Yes

Name of Conservation Agent who supervised plugging of this well Gilbert Balthazor
Producing formation _____ Depth to top _____ Bottom _____ Total Depth of Well _____
Show depth and thickness of all water, oil and gas formations.

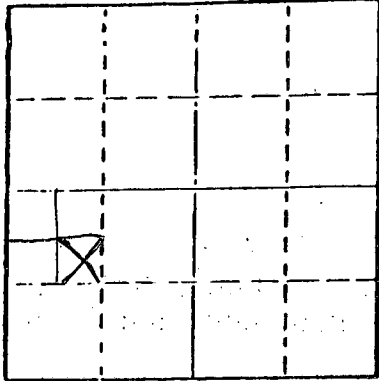

Locate well correctly on above
Section Plot

OIL, GAS OR WATER RECORDS

CASING RECORD

FORMATION	CONTENT	FROM	TO	SIZE	PUT IN	PULLED OUT
				8 5/8	209'	K.B. None

Describe in detail the manner in which the well was plugged, indicating where the mud fluid was placed and the method or methods used in introducing it into the hold. If cement or other plugs were used, state the character of same and depth placed from _____ feet to _____ feet for each plug set.

1st Plug set @ 1200' with 70 sx.
2nd Plug set @ 200' with 20 sx.
Bridged @ 40' with 10 sx.

AUG 13 1976

CONSERVATION DIVISION
Wichita, Kansas

Plug down at 8:45 a.m. August 7, 1976.
STATE PLUGGER: Gilbert Balthazor

8-13-76

(If additional description is necessary, use BACK of this sheet)

Name of Plugging Contractor _____


STATE OF Kansas COUNTY OF Sedgwick ss.
Jerry A. Langrehr-Exec. V.P. (employee of owner) or (owner or operator) of the above-described well, being first duly sworn on oath, says: That I have knowledge of the facts, statements, and matters herein contained and the log of the above-described well as filed and that the same are true and correct. So help me God.

(Signature) Gerry A. Langrehr
801 Union Center, Wichita, Ks. 67202
(Address)

Subscribed and sworn to before me this 12th day of August 1976

July 21, 1979

Sandra Richman
Sandra Richman Notary Public.

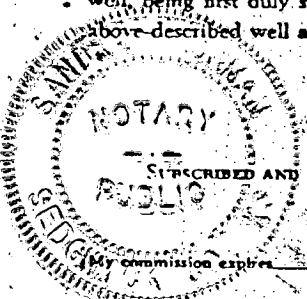

CONTRACTOR'S WELL LOG

OPERATOR: The Maurice L. Brown Co.
 CONTRACTOR: Abercrombie Drilling, Inc.
 WELL NAME: KNOLL #1
 LOCATION: SE NW SW, Section 4-9S-25W
 Graham County, Kansas
 SPUD DATE: July 27, 1976
 COMPLETION DATE: July 7, 1976

0	170	Surface Clay & Sand
170	1800	Shale
1800	2248	Shale & Sand
2248	2287	Anhydrite
2287	2918	Shale
2918	3375	Shale & Lime
3375	3780	Lime & Shale
3780	4100	Lime
	4100	Rotary Total Depth

Spud surface hole at 4:40 p.m. - 7-27-76. Cut 210', 12½" hole. Ran 5 Jts. 8 5/8". Tally 202', set at 209' K.B. Cemented with 190 sx. Class "A" cement, 3% Ca. Cl. Plug down at 9:00 p.m. 7-27-76. Cement did circulate. Will drill under surface at 9:00 a.m. 7-28-76.

RTD 4100', Plug at 1200' with 70 sx., 200' with 20 sx., bridged at 40' with 10 sx. - 50/50 posmix - 6% gel. Plug down at 8:45 a.m. 8-7-76. State Plugger - Gilbert Balthazor, Palco, Kansas.

RECEIVED
 STATE CONSERVATION COMMISSION

AUG 13 1976

CONSERVATION DIVISION
 Wichita, Kansas

8-13-76

SAMPLE TOPS:

Anhydrite 2249' (+315)
 B/Anhydrite 2283' (+281)

STATE OF KANSAS)
) SS
 COUNTY OF SEDGWICK)

Jerry A. Langrehr, Executive Vice President of Abercrombie Drilling, Inc., does hereby state that the above and foregoing is a true and correct copy of the log of the KNOLL #1, SE NW SW, Section 4-9S-25W, Graham County, Kansas.

ABERCROMBIE DRILLING, INC.

By: Jerry A. Langrehr
 Jerry A. Langrehr, Exec. V.P.

Subscribed and sworn to before me, a Notary Public, in and for the aforesaid county and state as of the 12th day of August, 1976.

Sandra Richman
 Sandra Richman, Notary Public

My Commission Expires: July 21, 1979.

COPY