

15-065-20900-00-00


STATE OF KANSAS
STATE CORPORATION COMMISSION

Form CP-4

Give All Information Completely
Make Required Affidavit
Mail or Deliver Report to:
Conservation Division
State Corporation Commission
P. O. Box 17027
Wichita, Kansas 67217
NORTH

WELL PLUGGING RECORD

Graham County, Sec. 6 Twp. 9S Rge. (E) 25 (W)
Location as "NE/CNW/SW" or footage from lines C SE SE
Lease Owner Koch Exploration Co.
Lease Name Knobel Well No. #16-6
Office Address P. O. Box 2256, Wichita, Kansas 67201
Character of Well (completed as Oil, Gas or Dry Hole) Dry Hole
Date well completed 2-9-77 19
Application for plugging filed 2-9-77 19
Application for plugging approved 2-9-77 19
Plugging commenced 2-9-77 19
Plugging completed 2-9-77 19
Reason for abandonment of well or producing formation
Commercial quantities of oil not found.
If a producing well is abandoned, date of last production 19
Was permission obtained from the Conservation Division or its agents before plugging was commenced? Yes

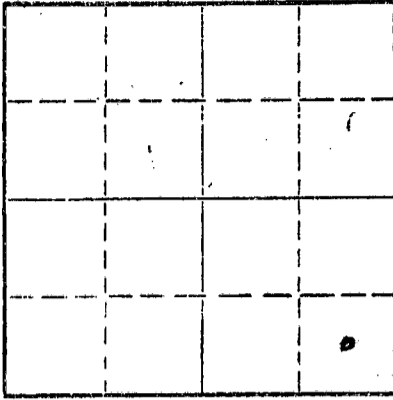

Locate well correctly on above Section Plat

Name of Conservation Agent who supervised plugging of this well Gilbert Balthazor, Palco, Kansas
Producing formation _____ Depth to top _____ Bottom _____ Total Depth of Well 4140' Feet
Show depth and thickness of all water, oil and gas formations.

OIL, GAS OR WATER RECORDS

CASING RECORD

FORMATION	CONTENT	FROM	TO	SIZE	PUT IN	PULLED OUT
				9 5/8"	222'	None

Describe in detail the manner in which the well was plugged, indicating where the mud fluid was placed and the method or methods used in introducing it into the hole. If cement or other plugs were used, state the character of same and depth placed, from _____ feet to _____ feet for each plug set.

Plug @ 1150' w/70 sx.
Plug @ 200' w/20 sx.
Plug @ 40' w/10 sx.

RECEIVED
STATE CORPORATION COMMISSION

FEB 16 1977

2-16-77

CONSERVATION DIVISION
Wichita, Kansas

Name of Plugging Contractor Rains & Williamson Oil Co., Inc.
Address 435 Page Court, 220 W. Douglas, Wichita, Kansas 67202

STATE OF Kansas, COUNTY OF Sedgwick, ss.
Wilson Rains, President of Rains & Williamson Oil Co., Inc. (employee of owner) or (owner or operator) of the above-described well, being first duly sworn on oath, says: That I have knowledge of the facts, statements, and matters herein contained and the log of the above-described well as filed and that the same are true and correct. So help me God.

(Signature) Wilson Rains
435 Page Court, 220 W. Douglas, Wichita, Kans. 67202
(Address)

Subscribed and sworn to before me this 14 day of February 1977
My commission expires 10-4-79



Juanita M. Green
Notary Public.

DRILLER'S LOG

15-069-20900-00-00

COMPANY: Koch Exploration Co.

SEC. 6 T. 9S R. 25W

WELL NAME: Knobel #16-6

LOC. C SE SE

COUNTY: Graham

RIG NO. #7

TOTAL DEPTH 4140'

ELEVATION

COMMENCED: 1-31-77

COMPLETED: 2-9-77

CONTRACTOR: Rains & Williamson Oil Co., Inc.

CASING RECORD:

SURFACE: 9 5/8" @ 222' w/250 sx. 60/40 poz., 2% gel, 3% cc.

PRODUCTION: D&A

LOG

(Figures Indicate Bottom of Formations)

Clay & Shale	231
Sand	320
Shale w/Sand	1320
Shale	1895
Sand	2073
Shale	2680
Shale & Lime	2910
Lime & Shale	3430
Lime	3545
Lime & Shale	3660
Lime	4140
<u>ROTARY TOTAL DEPTH</u>	<u>4140</u>

RECEIVED
STATE CORPORATION COMMISSION

FEB 16 1977

2-16-77

CONSERVATION DIVISION
Wichita, Kansas

STATE OF Kansas)

COUNTY OF Sedgwick)

SS:

I, Wilson Rains, President of Rains & Williamson Oil Co., Inc.

upon oath state that the above and foregoing is a true and correct copy of the log of the

Knobel #16-6 well.

Wilson Rains

Wilson Rains

Subscribed and sworn to before me this 14 day of February, 1977.

My Appointment Expires:

70-4-79

Juanita M. Green

Juanita M. Green

