


15-065-00187-0000

STATE OF KANSAS
STATE CORPORATION COMMISSION

WELL PLUGGING RECORD

Give All Information Completely
Make Required Affidavit
Mail or Deliver Report to:
Conservation Division
State Corporation Commission
800 Bitting Building
Wichita, Kansas

Graham County. Sec. 33 Twp. 2S Rge. (E) 22 (W)
Location as "NE/CNW $\frac{1}{4}$ SW $\frac{1}{4}$ " or footage from lines SE $\frac{1}{4}$ SE $\frac{1}{4}$ NW $\frac{1}{4}$
Lease Owner Fred Drilling Co.
Lease Name LOYD Well No. 1
Office Address 509 Orpheum Bldg., Wichita, Kansas
Character of Well (completed as Oil, Gas or Dry Hole) dry hole
Date well completed 4-21-1951
Application for plugging filed 4-20-1951
Application for plugging approved 4-20-1951
Plugging commenced 4-20-1951
Plugging completed 4-21-1951
Reason for abandonment of well or producing formation ---

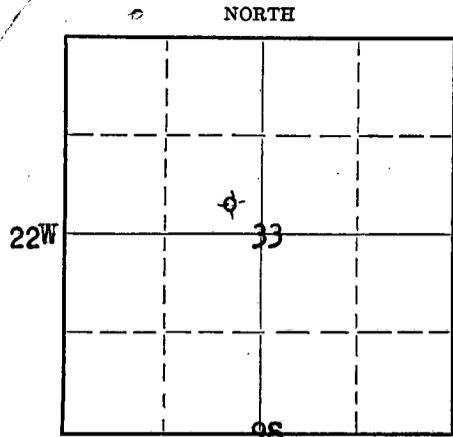

Locate well correctly on above
Section Plat

If a producing well is abandoned, date of last production --- 19---
Was permission obtained from the Conservation Division or its agents before plugging was commenced? yes

Name of Conservation Agent who supervised plugging of this well M.A. Rives
Producing formation --- Depth to top --- Bottom --- Total Depth of Well 4092 Feet
Show depth and thickness of all water, oil and gas formations.

OIL, GAS OR WATER RECORDS

CASING RECORD

Formation	Content	From	To	Size	Put In	Pulled Out
none	---	---	---	8-5/8" (12 1/2')	cemented at 120' w/100 sacks bulk cement and 1 sack Cal. Chloride.	none
					no oil string run - D&A	

Describe in detail the manner in which the well was plugged, indicating where the mud fluid was placed and the method or methods used in introducing it into the hole. If cement or other plugs were used, state the character of same and depth placed, from --- feet to --- feet for each plug set.

Filled hole with heavy mud to bottom of surface; set plug @ 100'; cemented to 1' below cellar collar. Pipe cut off 3' below level of ground.

(If additional description is necessary, use BACK of this sheet)

Correspondence regarding this well should be addressed to Fred Drilling Co.
Address 509 Orpheum Bldg., Wichita, Kansas

STATE OF Kansas, COUNTY OF Sedgwick, ss.
Robert F. Walters (employee of owner) ~~owner~~ of the above-described well, being first duly sworn on oath, says: That I have knowledge of the facts, statements, and matters herein contained and the log of the above-described well as filed and that the same are true and correct. So help me God.

(Signature) Robert F. Walters
509 Orpheum Building, Wichita, Kansas
(Address)

SUBSCRIBED AND SWORN to before me this 23rd day of April, 1951.

My commission expires June 28, 1952


23-5091-s 8-50-10M

D. Mages
STATE CORPORATIO... Notary Public.

APR 25 1951

CONSERVATION DIVISION
Wichita, Kansas

425-51

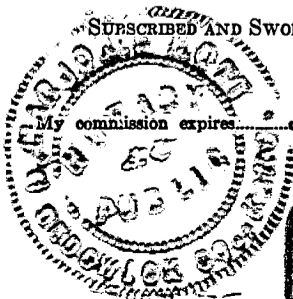

PLUGGING
FILE SEC 33T 9 RW
BOOK PAGE 77 LK 22

LOYD WELL # 1

Location:	SE/4 SE/4 NW/4 Sec. 33-9S-22W Graham County, Kansas	Spudded:	4-9-51
Operator:	Fred Drilling Co.	Completed:	4-21-51
Contractor:	Fred Drilling Co.	Elevation:	2374' Gr; 2377' DF; 2379' KB.
Surface Casing:	6 jts. (124') 8-5/8" cemented @ 120' w/100 sacks cement and 1 sack Calcium Chloride.	Total Depth:	4092'
Oil String:	None run - dry and abandoned 4-21-51		

T O P S (KB)

Anhydrite	1902 (+ 477)
Topeka	3373 (- 994)
Heebner	3598 (-1219)
Lansing-Kansas City	3639 (-1260)
Base of Kansas City	3870 (-1491)
Marmaton Chert Zone	3938 (-1559)
Snaly Conglomerate	4041 (-1661)
Arbuckle	4080 (-1701)
Rotary Total Depth	4092 (-1713)

L O G

(Figures indicate bottom of formation)

Sand, shale	0 to 125'
Clay, shale and sand	735
Shale and sand	1120
Shale	1450
Sand, shale and shells	1785
Shale	1902
Anhydrite	1937
Shale and shells	2040
Shale, shells	2235
Shale and shells	2435
Shale and shells	2565
Lime and shale	3211
Shale	3349
Shale and lime	3655
Lime	3802
Lime and shale	4003
Lime, shale and chert	4047
Shale and conglomerate	4080
Arbuckle	4092
Rotary Total Depth	4092'

The undersigned, Robert F. Walters of the Fred Drilling Co. hereby certifies that the above log is a true and correct log of the formations encountered in drilling the above noted well as reflected by the Daily Drilling Reports.

FRED DRILLING CO.

By Robert F. Walters

Subscribed and sworn to before
me on this 23rd day of April 1951.

D. Marjorie Mott
Notary Public

My commission expires: June 28, 1952.

PLUGGING
FILE SEC 33 T 9 R 22 W
BOOK PAGE 71 LINE 22

APR 25 1951
425-51