

15-065-00326-00-00


STATE OF KANSAS  
STATE CORPORATION COMMISSION

Give All Information Completely  
Make Required Affidavit  
Mail or Deliver Report to:  
Conservation Division  
State Corporation Commission  
800 Bittling Building  
Wichita, Kansas

WELL PLUGGING RECORD

Graham County. Sec. 34 Twp. 9S Rge. 22W (E) (W)

Location as "NE/CNW%SW%" or footage from lines SW NE SW  
Lease Owner Compass Oil & Uranium Company  
Lease Name Sandlin Well No. 1  
Office Address Denver, Colorado  
Character of Well (completed as Oil, Gas or Dry Hole) Oil well  
Date well completed ? 19  
Application for plugging filed September 15 19 55  
Application for plugging approved \_\_\_\_\_ 19  
Plugging commenced September 12 19 55  
Plugging completed September 13 19 55  
Reason for abandonment of well or producing formation Depleted

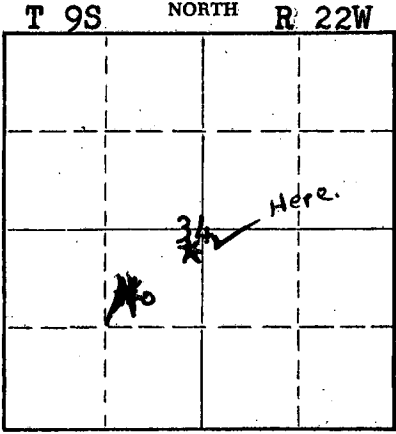

Locate well correctly on above Section Plat

If a producing well is abandoned, date of last production \_\_\_\_\_ 19  
Was permission obtained from the Conservation Division or its agents before plugging was commenced? Yes

Name of Conservation Agent who supervised plugging of this well Eldon Petty 4030'  
Producing formation \_\_\_\_\_ Depth to top \_\_\_\_\_ Bottom \_\_\_\_\_ Total Depth of Well 3809' Feet  
Show depth and thickness of all water, oil and gas formations.

OIL, GAS OR WATER RECORDS

CASING RECORD

FORMATION	CONTENT	FROM	TO	SIZE	PUT IN	PULLED OUT
				8-5/8"	278'	None
				5-1/2"	4039'	2041'
				Well was plugged back to 3809' and casing perforated at 3568'.		

Describe in detail the manner in which the well was plugged, indicating where the mud fluid was placed and the method or methods used in introducing it into the hole. If cement or other plugs were used, state the character of same and depth placed, from \_\_\_\_\_ feet to \_\_\_\_\_ feet for each plug set.

Filled the hole with sand from 3809' to 3500' and ran 4 sacks of cement. Mudded the hole to 275', set a 10' rock bridge and ran 15 sacks of cement at 265'. Mudded the hole to 35', set a rock bridge and ran 10 sacks of cement on top. Plugging completed.

RECEIVED  
STATE CORPORATION COMMISSION  
SEP 16 1955  
CONSERVATION DIVISION  
Wichita, Kansas

(If additional description is necessary, use BACK of this sheet)  
Name of Plugging Contractor West Supply Co., Inc. 9-16-55  
Address Chase, Kansas

STATE OF Kansas, COUNTY OF Rice, ss.  
Noel J. Knight (employee of owner) or (owner or operator) of the above-described well, being first duly sworn on oath, says: That I have knowledge of the facts, statements, and matters herein contained and the log of the above-described well as filed and that the same are true and correct. So help me God.

(Signature) Noel J. Knight  
Chase, Kansas (Address)

SUBSCRIBED AND SWORN to before me this 15th day of September, 19 55  
My commission expires May 20, 1957  
Edward E. O'Brien  
Notary Public.

