


15-065-02245-00-00

STATE OF KANSAS  
STATE CORPORATION COMMISSION

WELL PLUGGING RECORD

Give All Information Completely  
Make Required Affidavit  
Mail or Deliver Report to:  
Conservation Division  
State Corporation Commission  
800 Bitting Building  
Wichita, Kansas

T 9S NORTH R 22 W

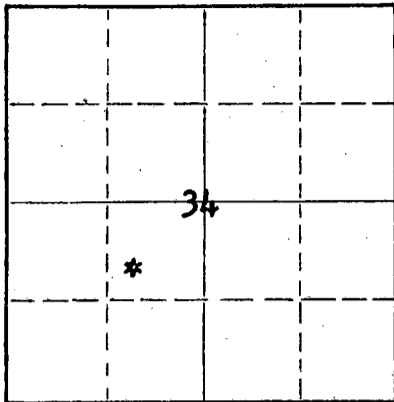

Locate well correctly on above  
Section Plat

Graham County. Sec. 34 Twp. 9S Rge. 22W (E) (W)  
Location as "NE/CNW&SW" or footage from lines SW NE SW  
Lease Owner Compass Oil & Uranium Company  
Lease Name Sandlin Well No. 2  
Office Address 924 Broadway - Denver, Colorado  
Character of Well (completed as Oil, Gas or Dry Hole) \_\_\_\_\_  
Date well completed \_\_\_\_\_ ? \_\_\_\_\_ 19 \_\_\_\_\_  
Application for plugging filed \_\_\_\_\_ September 8 \_\_\_\_\_ 19 55  
Application for plugging approved \_\_\_\_\_ 19 \_\_\_\_\_  
Plugging commenced \_\_\_\_\_ September 7 \_\_\_\_\_ 19 55  
Plugging completed \_\_\_\_\_ September 11 \_\_\_\_\_ 19 55  
Reason for abandonment of well or producing formation Depleted

If a producing well is abandoned, date of last production \_\_\_\_\_ 19 \_\_\_\_\_  
Was permission obtained from the Conservation Division or its agents before plugging was commenced? Yes

Name of Conservation Agent who supervised plugging of this well Eldon Petty  
Producing formation \_\_\_\_\_ Depth to top \_\_\_\_\_ Bottom \_\_\_\_\_ Total Depth of Well 3859 Feet  
Show depth and thickness of all water, oil and gas formations.

OIL, GAS OR WATER RECORDS

CASING RECORD

FORMATION	CONTENT	FROM	TO	SIZE	PUT IN	PULLED OUT
				8-5/8"	275'	None
				5-1/2"	3854'	1930'
				Hole was plugged back to 3805' and casing perforated at 3803'.		

Describe in detail the manner in which the well was plugged, indicating where the mud fluid was placed and the method or methods used in introducing it into the hole. If cement or other plugs were used, state the character of same and depth placed, from \_\_\_\_\_ feet to \_\_\_\_\_ feet for each plug set.

Filled the hole with sand from 3805' to 3300' and ran 4 sacks of cement. Mudded the hole to 275', set a 10' rock bridge and ran 15 sacks of cement. Mudded the hole to 35', set a 10' rock bridge and ran 10 sacks of cement. Plugging completed.

RECEIVED  
STATE CORPORATION COMMISSION

SEP 16 1955

CONSERVATION DIVISION  
Wichita, Kansas

(If additional description is necessary, use BACK of this sheet)  
Name of Plugging Contractor West Supply Co., Inc.  
Address Chase, Kansas

9-16-55

STATE OF Kansas, COUNTY OF Rice, ss.  
Noel J. Knight (employee of owner) or (owner or operator) of the above-described well, being first duly sworn on oath, says: That I have knowledge of the facts, statements, and matters herein contained and the log of the above-described well as filed and that the same are true and correct. So help me God.

(Signature) Noel J. Knight  
Chase, Kansas (Address)

SUBSCRIBED AND SWORN to before me this 15th day of September, 19 55  
My commission expires May 20, 1957  
Edward E. O'Brien Notary Public.



PLUGGING  
FILE SEC 34 Twp. 9S Rge. 22W  
BOOK PAGE 152 LINE 28