


15-065-30167-00-00

STATE OF KANSAS
STATE CORPORATION COMMISSION

WELL PLUGGING RECORD

Give All Information Completely
Make Required Affidavit
Mail or Deliver Report to
Conservation Division
State Corporation Comm.
245 North Water
Wichita, KS 67202

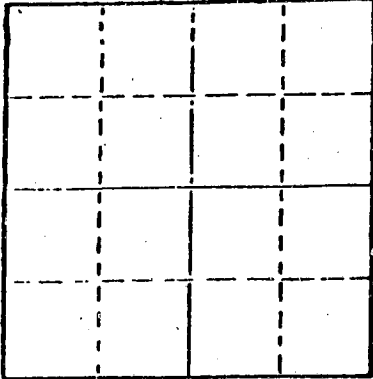

Locate well correctly on above
Section Plat

Graham County, Sec. 26 Twp. 9 Rge. 24 E/W
Location as "NE/CNW 1/4 SW 1/4" or footage from lines
NE NE NW

Lease Owner Dreiling Oil, Inc.

Lease Name Nickelson Well No. 5

Office Address Rt. #1, Victoria, KS 67671

Character of Well (Completed as Oil, Gas or Dry Hole)
Oil Well

Date Well completed 6-19 19 66

Application for plugging filed 5-11- 19 78

Application for plugging approved 5-12 19 78

Plugging commenced 6-14 19 78

Plugging completed 6-14 19 78

Reason for abandonment of well or producing formation
Depleted

If a producing well is abandoned, date of last production
March 19 78

Was permission obtained from the Conservation Division or
its agents before plugging was commenced? yes

Name of Conservation Agent who supervised plugging of this well Gilbert Balthazor

Producing formation _____ Depth to top _____ Bottom _____ Total Depth of Well 4075'

Show depth and thickness of all water, oil and gas formations.

OIL, GAS OR WATER RECORDS

CASING RECORD

FORMATION	CONTENT	FROM	TO	SIZE	PUT IN	PULLED OUT
Surface Pipe				8 5/8"	209'	0'
Casing				4 1/2"	4,074'	1200'

Describe in detail the manner in which the well was plugged, indicating where the mud fluid was placed and the method or methods used in introducing it into the hold. If cement or other plugs were used, state the character of same and depth placed, from _____ feet to _____ feet for each plug set.

Plugged with 130 sacks cement, 8 sacks gel, 3 sacks Hulls.
Maximum pressure 300#, shut in pressure 0#

RECEIVED
STATE CORPORATION COMMISSION
6/19/78
JUN 15 1978
CONSERVATION DIVISION
Wichita, Kansas

(If additional description is necessary, use BACK of this sheet)

Name of Plugging Contractor Dreiling Oil, Inc.

STATE OF KANSAS COUNTY OF ELLIS, ss.

I, Joseph A. Hess, Sec. Treas. of Drlg. Contrc. (employee of owner) or (owner or operator) of the above-described well, being first duly sworn on oath, says: That I have knowledge of the facts, statements, and matters herein contained and the log of the above-described well as filed and that the same are true and correct. So help me God.

(Signature)

Joseph A. Hess

JOSEPH A. HESS, Hays, KS 67601

(Address)

SUBSCRIBED AND SWORN TO before me this 16 day of June, 19 78

Cecilia Basgall
Cecilia Basgall

Notary Public.

CECILIA BASGALL
NOTARY PUBLIC
Ellis County, Kansas

My commission expires November 17, 1980