

STATE CORPORATION COMMISSION OF KANSAS  
OIL & GAS CONSERVATION DIVISION

WELL COMPLETION OR RECOMPLETION FORM  
ACO-1 WELL HISTORY

DESCRIPTION OF WELL AND LEASE

Operator: License # 5063  
Name Black Petroleum Company  
Address 527 Union Center Building  
City/State/Zip Wichita, Kansas 67202

Purchaser None

Operator Contact Person Thomas E. Black  
Phone 316-264-9342

Contractor: License # 5302  
Name Red Tiger Drilling Company

Wellsite Geologist H. Marvin Douglass  
Phone 264-9342

Designate Type of Completion

- New Well  Re-Entry  Workover
- Oil  SWD  Temp Abd
- Gas  Inj  Delayed Comp.
- Dry  Other (Core, Water Supply etc.)

If OWWO: old well info as follows:

Operator  
Well Name  
Comp. Date Old Total Depth

WELL HISTORY

Drilling Method:

- Mud Rotary  Air Rotary  Cable

3/9/86 3/18/86 3/19/86  
Spud Date Date Reached TD Completion Date  
3,557'  
Total Depth PBTD

Amount of Surface Pipe Set and Cemented at 281.61 feet  
Multiple Stage Cementing Collar Used?  Yes  No  
If yes, show depth set feet  
If alternate 2 completion, cement circulated from feet depth to w/ SX cmt

API NO. 15-163-22,876-00-00

County Rooks

C E/2 W/2 SE/4 5 10S 16W  East  West  
Sec Twp Rge

1320 Ft North from Southeast Corner of Section  
1650 Ft West from Southeast Corner of Section

(Note: Locate well in section plat below)


Lease Name Comeau Well # 1

Field Name

Producing Formation None

Elevation: Ground 1986 KB 1991

Section Plat

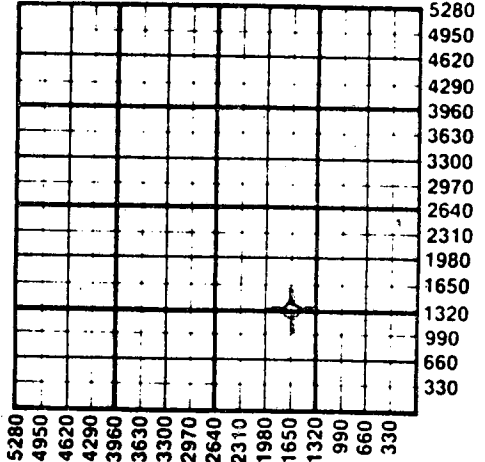

WATER SUPPLY INFORMATION

Disposition of Produced Water:  Disposal  Repressuring  
Docket #

Questions on this portion of the ACO-1 call:

Water Resources Board (913) 296-3717

Source of Water:

Division of Water Resources Permit #

Groundwater Ft North from Southeast Corner (Well) Ft West from Southeast Corner of Sec Twp Rge  East  West

Surface Water 1000 Ft North from Southeast Corner (Stream, pond, etc) 800 Ft West from Southeast Corner Sec 28 Twp 9S Rge 16  East  West

Other (explain) (purchased from city, R.W.D. #)

INSTRUCTIONS: This form shall be completed in duplicate and filed with the Kansas Corporation Commission, 200 Colorado Derby Building, Wichita, Kansas 67202, within 90 days after completion or recompletion of any well. Rule 82-3-130 and 82-3-107 apply.

Information on side two of this form will be held confidential for a period of 12 months if requested in writing and submitted with the form. See rule 82-3-107 for confidentiality in excess of 12 months.

One copy of all wireline logs and drillers time log shall be attached with this form. Submit CP-4 form with all plugged wells. Submit CP-111 form with all temporarily abandoned wells.

All requirements of the statutes, rules and regulations promulgated to regulate the oil and gas industry have been fully complied with and the statements herein are complete and correct to the best of my knowledge.

Signature Thomas E. Black

Title Owner Date 3-26-86

Subscribed and sworn to before me this 26th day of March 1986

Notary Public Martha C. Nussbaum

Date Commission Expires February 19, 1990

K.C.C. OFFICE USE ONLY  
 Letter of Confidentiality Attached  
 Wireline Log Received  
 Drillers Timelog Received  
Distribution  
 KCC  SWD/Rep  NGPA  
 KGS  Plug  Other (Specify)

MARTHA C. NUSSBAUM  
Notary Public  
2-19-90

APR - 3 1986 Form ACO-1 (7-84)

Sec. 5, Twp. 10 Rge. 16W