

STATE OF KANSAS
STATE CORPORATION COMMISSION

Give All Information Completely
Make Required Affidavit
Mail or Deliver Report to:
Conservation Division
State Corporation Commission
211 No. Broadway
Wichita, Kansas

WELL PLUGGING RECORD

Graham County, Sec. 15 Twp. 10S Rge. (E) 21 (W)

Location as "NE/CNWxSWx" or footage from lines SW NE NE

Lease Owner Petroleum Operating Company

Lease Name CHURCH Well No. 1

Office Address P. O. Box 7027, Tulsa, Oklahoma

Character of Well (completed as Oil, Gas or Dry Hole) Dry Hole

Date well completed 12-6 19 62

Application for plugging filed 12-6 19 62

Application for plugging approved 12-6 19 62


Plugging commenced 12-6 19 62

Plugging completed 12-6 19 62

Reason for abandonment of well or producing formation Dry Hole

If a producing well is abandoned, date of last production 19

Was permission obtained from the Conservation Division or its agents before plugging was commenced? yes

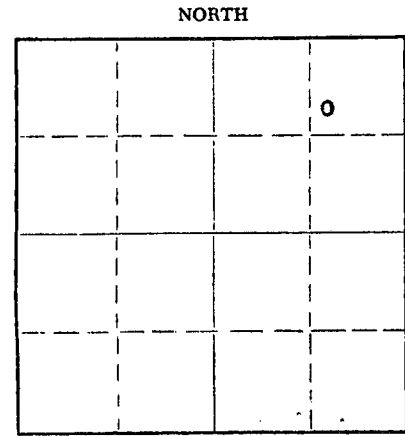

Locate well correctly on above Section Plat

Name of Conservation Agent who supervised plugging of this well Eldon Petty

Producing formation Dry Hole Depth to top Bottom Total Depth of Well 3850 Feet

Show depth and thickness of all water, oil and gas formations.

OIL, GAS OR WATER RECORDS

CASING RECORD

FORMATION	CONTENT	FROM	TO	SIZE	PUT IN	PULLED OUT
Lansing	mud	3517	3739	8-5/8"	209'	none

Describe in detail the manner in which the well was plugged, indicating where the mud fluid was placed and the method or methods used in introducing it into the hole. If cement or other plugs were used, state the character of same and depth placed, from feet to feet for each plug set.

Bottom plug @ 550' w/20 sax cement
Middle plug @ 200' w/1/4 sk hulls & 20 sax cement
Top plug @ 35' w/1/2 sk hulls & 10 sax cement

RECEIVED
STATE CORPORATION COMMISSION

JAN 2 1963

01-02-1963

CONSERVATION DIVISION
Wichita, Kansas

(If additional description is necessary, use BACK of this sheet)
Name of Plugging Contractor Rotary well drilled - no pipe set.
Address

STATE OF OKLAHOMA, COUNTY OF TULSA, ss.
Joseph Teichman (employee of owner) or (owner or operator) of the above-described well, being first duly sworn on oath, says: That I have knowledge of the facts, statements, and matters herein contained and the log of the above-described well as filed and that the same are true and correct. So help me God.

(Signature) Joseph Teichman

P.O. Box 7027, Tulsa, Okla. (Address)

SUBSCRIBED AND SWORN TO before me this 12th day of December, 1962

Vernie Hunter

Notary Public.

My commission expires 3-17-64



SHOLOM DRILLING COMPANY, INC.
P. O. Box 7027
Tulsa, Oklahoma

RECEIVED
STATE CORPORATION COMMISSION

15-065-01045-00-00
FORMATION LOG

JAN 2 1963
01-02-1963
CONSERVATION DIVISION
Wichita, Kansas

COMPANY: Petroleum Operating Company
FARM: CHURCH #1
LOCATION: SW NE NE Sec. 15 T10S R21W - Graham County, Kansas
ROTARY DRILLING CONTRACTOR: Sholom Drilling Company, Inc.

COMMENCED: 11-28-62
COMPLETED: 12-6-62
I. P.: D & A

Elevation: 2242' K.B.
Rotary TD: 3850'

Casing Record:
8-5/8" @ 209' w/140 sax

LOG

0 - 40 Clay
40 - 188 Shale
188 - 209 Plug & Cement
209 - 550 Shale
550 - 825 Shale & Sand
825 - 915 Sand
915 - 1220 Shale & Sand
1220 - 1380 Sand
1380 - 1450 Shale & Sand
1450 - 1719 Red Bed
1719 - 1767 Anhydrite
1767 - 2175 Shale & Shells
2175 - 3265 Lime & Shale
3265 - 3740 Lime
3740 - 3800 Lime & Shale
3800 - 3850 Conglomerate

DST #1 3636-3740
Rec. 30' mud

Anhydrite 1719-67 (dr.)
Topeka 3263'
Heebner 3476'
Toronto 3499'
Lansing 3517'
Base K.C. 3739'
Marmaton 3791'
Conglomerate 3805'
Total Depth 3850' in Cong.

STATE OF OKLAHOMA)
) ss.
COUNTY OF TULSA)

I, Joseph Teichman, President of Sholom Drilling Company, Inc. a corporation of the State of Oklahoma, domesticated in the State of Kansas, being first duly sworn under oath, says: That I have knowledge of the facts, statements and matters herein contained of the above described well as filed and that the same are true and correct.


Joseph Teichman

Subscribed and sworn to before me this 17th day of December, 1962.


Notary Public

My commission expires: 3-17-64

STATE OF OKLAHOMA
JAN 5 1963
CONSERVATION DIVISION