


Give All Information Completely
Make Required Affidavit
Mail or Deliver Report to:
Conservation Division
State Corporation Commission
800 Biting Building
Wichita, Kansas

15-065 - 00342-00-00

WELL PLUGGING RECORD

NORTH

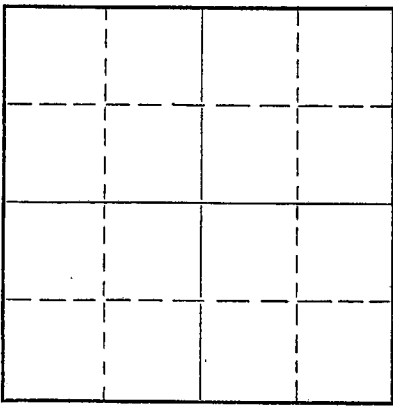

Locate well correctly on above
Section Plat

.....Graham.....County. Sec. 16 Twp. 10S Rge. (E) 21 (W)
Location as "NE/CNW $\frac{1}{4}$ SW $\frac{1}{4}$ " or footage from lines NE, NE, SW
Lease Owner Jones-Shelburne & Farmer, Inc.
Lease Name Noah E. Well No. 1
Office Address Russell, Kansas
Character of Well (completed as Oil, Gas or Dry Hole) Dry
Date well completed March 26 19 52
Application for plugging filed March 26 19 52
Application for plugging approved March 26 19 52
Plugging commenced March 26 19 52
Plugging completed March 26 19 52
Reason for abandonment of well or producing formation Dry

If a producing well is abandoned, date of last production Never Produced 19
Was permission obtained from the Conservation Division or its agents before plugging was commenced? yes

Name of Conservation Agent who supervised plugging of this well Elden Petty
Producing formation..... Depth to top..... Bottom..... Total Depth of Well 3815 Feet
Show depth and thickness of all water, oil and gas formations.


OIL, GAS OR WATER RECORDS

CASING RECORD

Formation	Content	From	To	Size	Put In	Pulled Out
				8 5/8	160'	None

Describe in detail the manner in which the well was plugged, indicating where the mud fluid was placed and the method or methods used in introducing it into the hole. If cement or other plugs were used, state the character of same and depth placed, from.....feet to.....feet for each plug set.

- Hole filled to 155' with heavy mud
- Halliburton plug pushed to 155'
- $\frac{1}{2}$ sack hulls dumped on top of plug.
- 15 sacks cement mixed and dumped on top of hulls.
- Hole filled to 40'
- Halliburton plug pushed to 40'
- $\frac{1}{2}$ sack hulls mixed and dumped on top of plug.
- 10 sacks cement mixed and hole filled to top with sand.

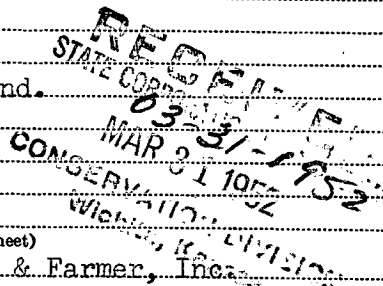

(If additional description is necessary, use BACK of this sheet)

Correspondence regarding this well should be addressed to Jones-Shelburne & Farmer, Inc.
Address Russell, Kansas

STATE OF Kansas, COUNTY OF Russell, ss.
John O. Farmer, Vice-Pres. (employee of owner) or (owner or operator) of the above-described well,
being first duly sworn on oath, says: That I have knowledge of the facts, statements, and matters herein contained and the log of the above-described well as filed and that the same are true and correct. So help me God.

(Signature) *John O. Farmer*
Russell, Kansas
(Address)

SUBSCRIBED AND SWORN to before me this 29th day of March, 19 52
Sept. 30, 1954.
My commission expires



Notary Public.

PLUGGING
FILE REC 16T 10 R 21 W
BOOK PAGE 5 LINE 11

OPERATOR Jones-Shelburne & Farmer, Inc.


15-065-00342-00-00

FORMATION RECORD

ADDRESS Russell, Kansas

Give detailed description and thickness of all formations drilled through, contents of sand, whether dry, water, oil or gas.

640 Acres
N

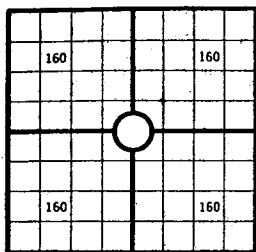

Locate well correctly

COUNTY Graham SEC. 16 TWP. 10S RGE. 21W
 COMPANY OPERATING Jones-Shelburne & Farmer, Inc.
 OFFICE ADDRESS Russell, Kansas
 FARM NAME Moah WELL NO. 1
 DRILLING STARTED 3-15-52 DRILLING FINISHED 3-24-52
 DATE OF FIRST PRODUCTION _____ COMPLETED _____
 WELL LOCATED NE 1/4 - NE 1/4 - S 1/4 - W 1/4 North of South
CS 1-18-52 ft. East of West Line of Quarter Section
 Elevation (Relative to sea level) DERRICK FLOOR _____ GROUND _____
 CHARACTER OF WELL (Oil, gas or dryhole) Dry

Formation	Top	Bottom	Formation	Top	Bottom
Shale & Shells	0	140			
Sand Shale & Shell	140	1240			
Shale, shells	1240	2240			
Lime & Shale	2240	3550			
Lime	3550	3665			
Lime & Shale	3665	3766			
Shale & Lime	3766	3790			
Arbuckle	3790				
Total Depth	3815				

OIL OR GAS SANDS OR ZONES

Name	From	To	Name	From	To
1			4		
2			5		
3			6		

Perforating Record If Any

Shot Record

Formation	From	To	No. of Shots	Formation	From	To	Size of Shot

CASING RECORD

Amount Set								Amount Pulled		Packer Record	
Size	Wt.	Thds.	Make	Ft.	In.	Ft.	In.	Size	Length	Depth Set	Make
8 5/8	24	2	Lin	165				none			

Liner Record: Amount _____ Kind _____ Top _____ Bottom _____

CEMENTING AND MUDDING

Size	Amount Set		Sacks Cement	Chemical		Method of Cementing	Amount	Mudding Method	Results (See Note)
	Ft.	In.		Gal.	Make				
8 5/8	165		100						

Note: What method was used to protect sands if outer strings were pulled? _____

NOTE: Were bottom hole plugs used? _____ If so, state kind, depth set and results obtained _____

TOOLS USED

Rotary Tools were used from _____ feet to _____ Cable tools were used from _____ feet to _____

_____ feet, and from _____ feet to _____ feet, and from _____ feet to _____

Type Rig _____

INITIAL PRODUCTION TEST

Describe initial test: whether by flow through tubing or casing or by pumping _____

Amount of Oil Production _____ bbls. Size of choke, if any _____ Length of test _____ Water

Production _____ bbls. Gravity of oil _____ Type of Pump if pump is used, describe _____

I, the undersigned, being first duly sworn upon oath, state that this well record is true, correct and complete according to the records of this office and to the best of my knowledge and belief.

Jones O Farmer - Dege
Name and title of representative of company

Subscribed and sworn to before me this 29 day of June 1952
 My Commission expires 9-30-54
 Notary Public.

FILE SEC-16-10-R-210
 BOOK PAGE-5-LINELL

08-31-1952

FARM NAME _____ CO. _____ WELL NO. 1 COUNTY Graham TWP 10S., RGE. 21W. SEC. 16.