


STATE OF KANSAS  
STATE CORPORATION COMMISSION

Give All Information Completely  
Make Required Affidavit  
Mail or Deliver Report to:  
Conservation Division  
State Corporation Commission  
800 Bitting Building  
Wichita, Kansas

15-065-00378-00-00  
WELL PLUGGING RECORD

NORTH

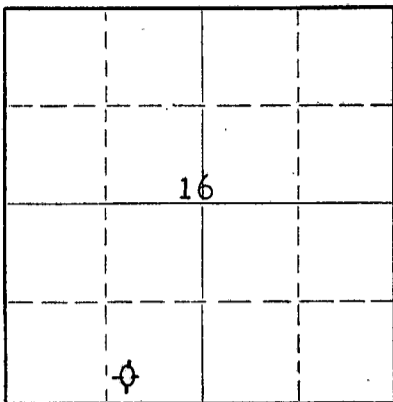

Locate well correctly on above  
Section Plat

Graham County, Sec. 16 Twp. 10S Rge. (E) 21W(W)  
Location as "NE/CNW&SW" or footage from lines SW SE SW  
Lease Owner Rocket Drilling Company  
Lease Name Noah Well No. 1  
Office Address 352 North Broadway, Wichita 2, Kansas  
Character of Well (completed as Oil, Gas or Dry Hole) Dry Hole  
Date well completed May 29, 19 53  
Application for plugging filed May 29, 19 53  
Application for plugging approved June 1, 19 53  
Plugging commenced May 29, 19 53  
Plugging completed May 29, 19 53  
Reason for abandonment of well or producing formation ---

If a producing well is abandoned, date of last production --- 19 ---  
Was permission obtained from the Conservation Division or its agents before plugging was commenced? Yes

Name of Conservation Agent who supervised plugging of this well Eldon Petty, Box 326, Hays, Kansas  
Producing formation \_\_\_\_\_ Depth to top \_\_\_\_\_ Bottom \_\_\_\_\_ Total Depth of Well 3850 Feet  
Show depth and thickness of all water, oil and gas formations.

OIL, GAS OR WATER RECORDS

CASING RECORD

FORMATION	CONTENT	FROM	TO	SIZE	PUT IN	PULLED OUT
				8-5/8"	160'	None

Describe in detail the manner in which the well was plugged, indicating where the mud fluid was placed and the method or methods used in introducing it into the hole. If cement or other plugs were used, state the character of same and depth placed, from \_\_\_\_\_ feet to \_\_\_\_\_ feet for each plug set.

- Filled hole with mud to 160'. Set plug and cemented with 15 sacks. Filled hole with mud to 40'. Set plug and cemented with 10 sacks.

RECEIVED  
STATE CORPORATION COMMISSION  
JUN 3 1953  
06-03-1953  
CONSERVATION DIVISION  
Wichita, Kansas

(If additional description is necessary, use BACK of this sheet)

Name of Plugging Contractor Rocket Drilling Company  
Address 352 North Broadway, Wichita 2, Kansas

STATE OF Kansas, COUNTY OF Sedgwick, ss.  
B. W. Burks (employee of owner ~~XXXXXXXXXXXX~~) of the above-described well, being first duly sworn on oath, says: That I have knowledge of the facts, statements and matters herein contained and the log of the above-described well as filed and that the same are true and correct. So help me God.

(Signature) [Signature]  
352 North Broadway, Wichita 2, Kansas  
(Address)

SUBSCRIBED AND SWORN to before me this 1st day of June, 1953  
Barbara Newby  
Notary Public.

My commission expires 12-3-55

PLUGGING  
FILE SEC 16 T 10 R 21W  
BOOK 164 LINE 30

15-065-00378-00-00

ROCKET DRILLING COMPANY  
352 North Broadway  
Wichita 2, Kansas

Rocket Drilling Company, Etal  
352 North Broadway  
Wichita 2, Kansas

#1 Noah  
SW SE SW, 16-10-21W  
Graham County, Kansas

Elevation: 2218 R.B.  
Spudded: May 20, 1953  
Rotary Completed: May 29, 1953  
Cable Tools Completed: None  
Acid Treatment: None  
Initial Production: Dry & Abandoned  
Contractor: Rocket Drilling Company

CASING RECORD

160' 8-5/8" O. D. 24# Seamless Casing Cemented W/105 Sacks Cement.  
5-1/2" None.

DRILLERS LOG

Sand	0 to 30	Lime	2470 to 2570
Blue Shale & Shells	160	Lime & Shale	2725
Shale & Shells	785	Shale & Lime	3000
Sand	950	Lime & Shale	3135
Shale & Shells	1066	Shale & Shells	3266
Sand	1104	Lime	3395
Shale	1116	Shale & Lime	3463
Red Bed & Sand	1450	Lime	3716
Shale	1700	Lime & Shale	3755
Anhydrite	1740	Lime & Chert	3807
Shale & Shells	2085	Arbuckle Shale	3832
Shale & Lime	2470	Arbuckle Lime	3805 TD

STATE OF KANSAS) SS:  
SEDGWICK COUNTY)

I hereby certify that to the best of my knowledge and belief,  
the foregoing log is true and correct.

RECEIVED  
STATE CORPORATION COMMISSION  
06-03-1953  
JUN 3 1953  
CONSERVATION DIVISION  
Wichita, Kansas

**PLUGGING**

FILE SEC 16 T 10 R 21W  
BOOK PAGE 104 LINE 30

ROCKET DRILLING COMPANY

By [Signature]



Subscribed and sworn to before me, a Notary Public, in and for  
the State and County aforesaid this 1st day of June, 1953.

My Commission Expires: 12-3-55

Barbara Newby  
Notary Public