


15-065-00883-00-00

STATE OF KANSAS
STATE CORPORATION COMMISSION

Give All Information Completely
Make Required Affidavit
Mail or Deliver Report to:
Conservation Division
State Corporation Commission
211 No. Broadway
Wichita, Kansas

WELL PLUGGING RECORD

NORTH

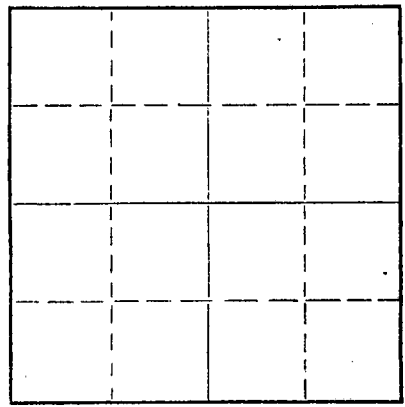

Locate well correctly on above
Section Plat

Graham County. Sec. 17 Twp. 10S Rge. 21W (E) (W)
Location as "NE/CNW&SW&" or footage from lines SW SW NE
Lease Owner El Dorado Refining Co.
Lease Name GRECIAN Well No. 1
Office Address Box 551, El Dorado, Kansas
Character of Well (completed as Oil, Gas or Dry Hole) Dry
Date well completed 12/18/56 19
Application for plugging filed 12/17/56 19
Application for plugging approved 12/17/56 19
Plugging commenced 12/18/56 19
Plugging completed 12/18/56 19
Reason for abandonment of well or producing formation Dry

If a producing well is abandoned, date of last production _____ 19____
Was permission obtained from the Conservation Division or its agents before plugging was commenced? yes

Name of Conservation Agent who supervised plugging of this well Eldon Petty
Producing formation _____ Depth to top _____ Bottom _____ Total Depth of Well 3920 Feet
Show depth and thickness of all water, oil and gas formations.

OIL, GAS OR WATER RECORDS

CASING RECORD

FORMATION	CONTENT	FROM	TO	SIZE	PUT IN	PULLED OUT
				8 5/8	257'	none

Describe in detail the manner in which the well was plugged, indicating where the mud fluid was placed and the method or methods used in introducing it into the hole. If cement or other plugs were used, state the character of same and depth placed, from _____ feet to _____ feet for each plug set.

PLUGGING RECORD

Filled with heavy mud from 3920 up to 240. Set wood plug @ 240' with 1/3 sack hulls and 15 sacks cement up to 210'. Filled with heavy mud from 210' up to 40'. Set wood plug with 1/3 sacks hulls and 10 sacks cement to cellar 0. Job completed 11:45 p.m. 12/18/56

(If additional description is necessary, use BACK of this sheet)

Name of Plugging Contractor Sierra Petroleum Co., Inc.
Address 420 W. Douglas Ave., Wichita, Kansas


STATE OF KANSAS, COUNTY OF RUSSELL, ss.
C. T. Honaker (employee of owner) or (owner or operator) of the above-described well, being first duly sworn on oath, says: That I have knowledge of the facts, statements, and matters herein contained and the log of the above-described well as filed and that the same are true and correct. So help me God.

(Signature) C. T. Honaker

(Address) _____, 19 56

SUBSCRIBED AND SWORN to before me this 20th day of December, 19 56
My commission expires 1-30-57.

Margie Cooper
Notary Public.

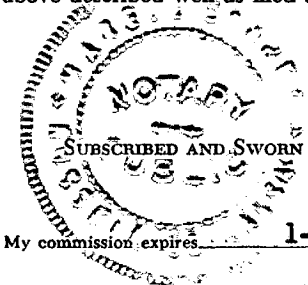

PLUGGING
FILE SEC. 17 T. 10 R. 21W
BOOK PAGE 127 LINE 19

DEC 22 1956
12-22-1956
CONSERVATION DIVISION
Wichita, Kansas

15-065-00883-00-00

El Dorado Refining Co.

Sierra Petroleum Co., Inc. - Contr.

GRECIAN #1

SW SW NE Sec. 17-10S-21W
Graham County, Kansas

Total Depth: 3920

Elev: 2279 KB

Comm: 12/8/56
Comp: 12/18/56

Casing:

Cement:

8 5/8" @ 257'

with 160 sacks cement

FORMATION	DEPTH
Post Rock	30
Shale & sand	110
Shale & shells	375
Shale	650
Sand & shale	740
Shale & shells	890
Sand	1020
Shale & shells	1250
Sand & shale	1450
Shale & shells	1595
Red Bed	1760
Anhydrite	1800
Shale & shells	2060
Shale & salt	2200
Lime & shale	3529
Lime	3814
Lime & shale	3897
Arbuckle	3920

Tops:	DEPTH
Anhydrite	1760
Heebner	3501
Toronto	3526
K. C.	3543
Base K.C.	3775
Arbuckle	3897

STATE OF KANSAS)
) ss:
COUNTY OF RUSSELL)

I hereby certify that the above information is true and correct to the best of my knowledge.

C. R. Honaker

Subscribed and sworn to before me this 20th day of December,

Margie Craper
Notary Public



PLUGGING
FILE SEC 17 T 10 R 21W
BOOK PAGE 127 LINE 19

REC'D
STATE CORPORATION DIVISION
DEC 22 1956
12-22-1956
CONSERVATION DIVISION
Wichita, Kansas