


Give All Information Completely  
Make Required Affidavit  
Mail or Deliver Report to:  
Conservation Division  
State Corporation Commission  
211 No. Broadway  
Wichita, Kansas

15-065-00004-00-00

WELL PLUGGING RECORD

NORTH

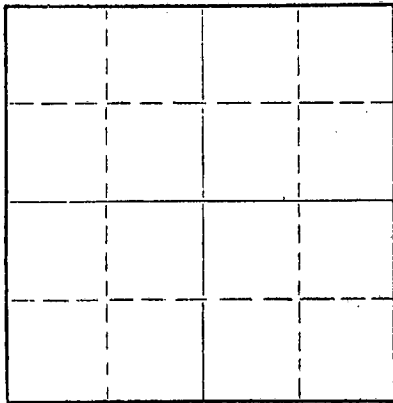

Locate well correctly on above  
Section Plat

Graham County. Sec. 18 Twp. 10S Rge. 21 (W)

Location as "NE/CNW&SW¼" or footage from lines SE SW NW

Lease Owner Glickman Oil - Houston Petroleum Co.

Lease Name Teall

Well No. 1

Office Address 702 S. St. Francis, Wichita, Kansas

Character of Well (completed as Oil, Gas or Dry Hole) Dry Hole

Date well completed February 16 1962

Application for plugging filed February 16 1962

Application for plugging approved February 16 1962

Plugging commenced 11/16 Feb. 16 1962

Plugging completed February 16 1962

Reason for abandonment of well or producing formation

If a producing well is abandoned, date of last production 19

Was permission obtained from the Conservation Division or its agents before plugging was commenced? Yes

Name of Conservation Agent who supervised plugging of this well Eldon Petty, Hays, Kansas

Producing formation Depth to top Bottom Total Depth of Well 3931 Feet

Show depth and thickness of all water, oil and gas formations.

OIL, GAS OR WATER RECORDS

CASING RECORD

| FORMATION | CONTENT | FROM | TO | SIZE   | PUT IN | PULLED OUT |
|-----------|---------|------|----|--------|--------|------------|
|           |         |      |    | 8-5/8" | 204'   | None       |
|           |         |      |    |        |        |            |
|           |         |      |    |        |        |            |
Describe in detail the manner in which the well was plugged, indicating where the mud fluid was placed and the method or methods used in introducing it into the hole. If cement or other plugs were used, state the character of same and depth placed, from feet to feet for each plug set.

Set plug @ 550' and cemented w/20 sxs. Fill hole to 180'

Set plug & cemented w/20 sxs.

Fill hole to 35' Set plug & Halls and cemented w/8 sxs

2 sxs in Rat Hole

RECEIVED  
STATE CORPORATION COMMISSION

MAR 30 1962  
03-30-1962  
CONSERVATION DIVISION  
Wichita, Kansas

(If additional description is necessary, use BACK of this sheet)

Name of Plugging Contractor Glickman Oil Company

Address P. O. Box 3104, Washington St. Station, Wichita, 2 Kansas

STATE OF Kansas, COUNTY OF Sedgwick, ss.

Milton Glickman

(employee of owner) or (owner or operator) of the above-described well, being first duly sworn on oath, says: "That I have knowledge of the facts, statements, and matters herein contained and the log of the above-described well as filed and that the same are true and correct. So help me God.

(Signature)

P. O. Box 3104, Wichita 2, Kansas

(Address)

SUBSCRIBED AND SWORN TO before me this 16th day of March


March

19 62

November 19, 1963

Lorella Schauf

Notary Public.

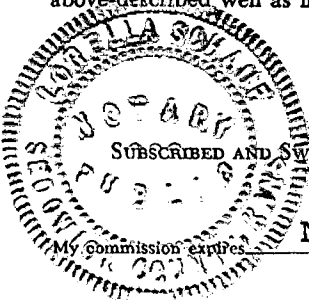

## GLICKMAN OIL COMPANY

P. O. Box 3108

Wichita, Kansas

15-065-00004-00-00

## DRILLERS WELL LOG

REC  
STATE OF KANSASMAR 30 1962  
CONSERVATION DIVISION  
WICHITA, KANSAS

Company: Glickman - Houston Oil Company

Location: SE SW NW

Sec. 18-10S-21W

Graham Co., Kansas

Farm: Teall

Well No. 1

Elevation: 2301 KB

Commenced: 2-8-62

Completed: 2-16-62

Total Depth: 3931'

Casing: 8-5/8" @ 204' w/140 sxs.

Production: D &amp; A

-----  
Geologist Jim Morris  
-----

Figures Indicate Bottom of Formations

|      |                                |                     |      |
|------|--------------------------------|---------------------|------|
| 15   | Surface Clay                   |                     |      |
| 25   | Sand                           |                     |      |
| 211  | Shale w/Lime streaks           | TOPS                |      |
| 470  | Shale                          |                     |      |
| 893  | Shale & Red Bed                | Anhydrite           | 1777 |
| 1100 | Sand & Shale                   | Heebner             | 3525 |
| 1250 | Shale                          | Toronto             | 3547 |
| 1777 | Shale & Red bed & Sand Streaks | Lansing-Kansas City | 3565 |
| 1810 | Anhydrite                      | Conglomerate        | 3894 |
| 1840 | Anhydrite                      | Simpson Shale       | 3912 |
| 1860 | Shale & Shells                 | Arbuckle            | 3925 |
| 2360 | Shale & Lime                   |                     |      |
| 2610 | Lime & Shale                   |                     |      |
| 2665 | Sandy Lime - Shale - Chert     |                     |      |
| 3405 | Lime & Shale                   |                     |      |
| 3465 | Lime                           |                     |      |
| 3570 | Lime & Shale                   |                     |      |
| 3820 | Lime                           |                     |      |
| 3825 | Lime & Shale                   |                     |      |
| 3880 | Conglomerate & Lime Cherty     |                     |      |
| 3906 | Lime & Chert                   |                     |      |
| 3926 | Conglomerate                   |                     |      |
| 3931 | Arbuckle Lime                  |                     |      |
| 3931 | RTD                            |                     |      |

STATE OF KANSAS, COUNTY OF SEDGWICK, ss:

I, Milton Glickman, of the Glickman Oil Company, upon oath state that the above and foregoing is a true and correct copy of the log of the Teall #1

Milton Glickman

Partner

Subscribed and sworn to before me this 16th day of March, 1962Lorella Schauf

Notary Public

My Commission Expires: November 19, 1963