

STATE OF KANSAS
STATE CORPORATION COMMISSION


Give All Information Completely
Make Required Affidavit
Mail or Deliver Report to:
Conservation Division
State Corporation Commission
212 No. Market
Wichita, Kansas

15-065-20011-00-00

Form CP-4

WELL PLUGGING RECORD

NORTH

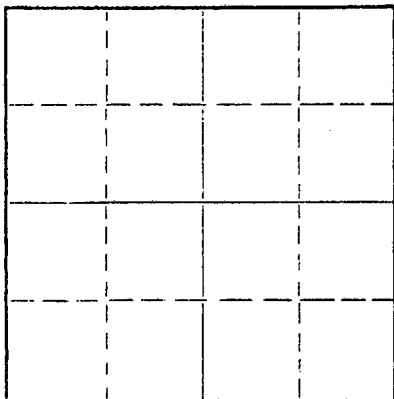

Locate well correctly on above
Section Plat

Graham County. Sec. 8 Twp. 9 Rge. 25 (E) XXXXX (W)
Location as "NE/CNW/SW" or footage from lines. NE NE SE
Lease Owner Theodore Gore
Lease Name Williams Well No. 1
Office Address 650 4th Natl. Bank Bldg., Wichita, Kansas 67202
Character of Well (completed as Oil, Gas or Dry Hole) Dry Hole
Date well completed February 15 19 67
Application for plugging filed February 15 19 67
Application for plugging approved February 15 19 67
Plugging commenced February 15 19 67
Plugging completed February 15 19 67
Reason for abandonment of well or producing formation Dry Hole

If a producing well is abandoned, date of last production 19
Was permission obtained from the Conservation Division or its agents before plugging was commenced? yes

Name of Conservation Agent who supervised plugging of this well W. L. Nichols, Morland, Kansas
Producing formation Depth to top Bottom Total Depth of Well 4065 Feet
Show depth and thickness of all water, oil and gas formations.

OIL, GAS OR WATER RECORDS

CASING RECORD

FORMATION	CONTENT	FROM	TO	SIZE	PUT IN	PULLED OUT
	Surface-Shale	0	320	8 5/8"	115'	-0-

Describe in detail the manner in which the well was plugged, indicating where the mud fluid was placed and the method or methods used in introducing it into the hole. If cement or other plugs were used, state the character of same and depth placed, from feet to feet for each plug set.

Plug set at 540' with 20 sacks cement.
Plug set at 120' with 20 sacks cement and hulls.
Plug set at 40' with 10 sacks cement.

RECEIVED
STATE CORPORATION COMMISSION

MAR 1 1967

3-1-67

CONSERVATION DIVISION
Wichita, Kansas

(If additional description is necessary, use BACK of this sheet)

Name of Plugging Contractor Empire Drilling Company
Address 650 4th Natl. Bank Bldg., Wichita, Kansas 67202

STATE OF KANSAS, COUNTY OF SEDGWICK, ss.
Theodore Gore

(employee of owner) (owner or operator) of the above-described well, being first duly sworn on oath, says: That I have knowledge of the facts, statements, and matters herein contained and the log of the above-described well as filed and that the same are true and correct. So help me God.

(Signature)

Theodore Gore
650 4th Natl. Bank Bldg., Wichita, Kansas 67202
(Address)

SUBSCRIBED AND SWORN TO before me this 22nd day of February, 19 67

My commission expires September 14, 1968.

Sandra Kay Peer

Notary Public.

L O G

15-065-20011-00-00

COMPANY: Theodore Gore
 CONTRACTOR: Empire Drilling Company
 FARM: Williams #1
 LOCATION: NE NE SE Section 8-9S-25W, Graham County, Kansas
 COMMENCED: February 8, 1967
 COMPLETED: February 15, 1967
 ELEVATION: 2522 KB
 POTENTIAL: D & A

0	to	320	Surface-Shale
320	to	1275	Shale & Bentonite
1275	to	1680	Shale
1680	to	1780	Shale & Gypsum
1780	to	1985	Sand
1985	to	2210	Shale
2210	to	2244	Anhydrite
2244	to	2665	Shale
2665	to	3125	Shale & Lime
3125	to	4065	Lime
4065			Rotary Total Depth

SET: 115' of 8 5/8" with 80 sacks cement.

SAMPLE LOG TOPS:

Anhydrite	2210	+312
Base Anhydrite	2244	+278
Heebner	3776	-1254
Toronto	3798	-1276
Lansing	3820	-1298
Muncie Creek	3938	-1416
Base Kansas City	4051	-1529
Total Depth	4065	-1543

RECEIVED
 STATE CORPORATION COMMISSION
 MAR 1 1967
 3-1-67
 CONSERVATION DIVISION
 Wichita, Kansas

C E R T I F I C A T I O N

I, Theodore Gore, do hereby certify that the above and foregoing is a true and correct copy of the log on the Williams #1, NE NE SE Section 8-9S-25W, Graham County, Kansas, as reflected by the files of Empire Drilling Company.

Theodore Gore
 Theodore Gore

Subscribed and sworn to before me, a Notary Public, within and for Sedgwick County, Kansas, this 22nd day of February, 1967.

Sandra Kay Peer
 Sandra Kay Peer, Notary Public

My commission expires September 14, 1968.

