


15-065-20798-00-00

STATE OF KANSAS
STATE CORPORATION COMMISSION

Form CP-4

Give All Information Completely
Make Required Affidavit
Mail or Deliver Report to:
Conservation Division
State Corporation Commission
P. O. Box 17027
Wichita, Kansas 67217
NORTH

WELL PLUGGING RECORD

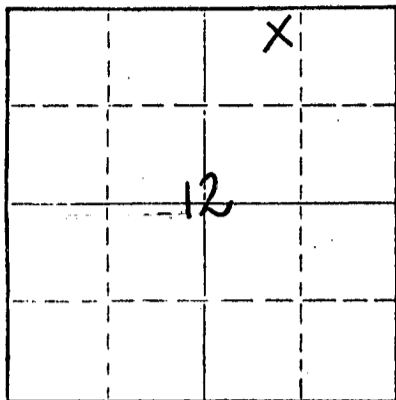

Locate well correctly on above
Section Plat

Graham County, Sec. 12 Twp. 9S Rge. 25(W)
Location as "NE/CNWxSWx" or footage from lines NE NW NE
Lease Owner The Maurice L. Brown Company
Lease Name CLARK Well No. #1
Office Address 1500 Vickers KSB&T Building
Character of Well (completed as Oil, Gas or Dry Hole) Dry Hole
Date well completed November 28, 1975
Application for plugging filed (verbally) November 28, 1975
Application for plugging approved (verbally) November 28, 1975
Plugging commenced November 28, 1975
Plugging completed November 28, 1975
Reason for abandonment of well or producing formation No commercial quantity
of oil or gas encountered.
If a producing well is abandoned, date of last production 19____
Was permission obtained from the Conservation Division or its agents before plugging was com-
menced? Yes

Name of Conservation Agent who supervised plugging of this well Gilbert Balthazor
Producing formation _____ Depth to top _____ Bottom _____ Total Depth of Well 4081' Feet
Show depth and thickness of all water, oil and gas formations.

OIL, GAS OR WATER RECORDS

CASING RECORD

FORMATION	CONTENT	FROM	TO	SIZE	PUT IN	PULLED OUT
				8 5/8"	203'	none

Describe in detail the manner in which the well was plugged, indicating where the mud fluid was placed and the method or methods used
in introducing it into the hole. If cement or other plugs were used, state the character of same and depth placed, from _____ feet to
_____ feet for each plug set.

1st Plug was Set @ 1000' with 70 sx. cement
2nd Plug was Set @ 200' with 20 sx. cement
3rd Plug was Set @ 40' with 10 sx. cement
Plug was down @ 12:30 p.m. November 28, 1975

RECEIVED
STATE CORPORATION COMMISSION

DEC 8 1975

CONSERVATION DIVISION
Wichita, Kansas

12-8-75

(If additional description is necessary, use BACK of this sheet)
Name of Plugging Contractor Abercrombie Drilling, Inc
Address 801 Union Center, Wichita, Kansas 67202

STATE OF KANSAS COUNTY OF SEDGWICK ss.
Jerry A. Langrehr-Exec. Vice President (employee of owner) or (owner or operator) of the above-described
well, being first duly sworn on oath, says: That I have knowledge of the facts, statements, and matters herein contained and the log of the
above-described well as filed and that the same are true and correct. So help me God.

(Signature) Jerry A. Langrehr
801 Union Center, Wichita, Ks. 67202
(Address)

Sworn to before me this 5th day of December, 1975

July 21, 1979

Margo Dee Montgomery
Notary Public.



CONTRACTOR'S WELL LOG

15-065-20798-00-00

OPERATOR:
 CONTRACTOR:
 WELL NAME:
 LOCATION:

 GEOLOGIST:
 SPUD DATE:
 COMPLETION DATE:

The Maurice L. Brown Company
 Abercrombie Drilling, Inc.
 CLARK #1
 NE NW NE Section 12-9S-25W
 Graham County, Kansas
 Dick Roby
 November 9, 1975
 November 28, 1975

0	208	Surface dirt, sand & shale
-208	1096	Shale
1096	1805	Shale and sand
1805	2185	Shale
2185	2215	Red bed
2215	2256	Anhydrite
2256	2440	Shale & shells
2440	2756	Shale
2756	2935	Shale & Lime
2935	3033	Shale
3033	3877	Shale & lime
3877	4090	Lime
	4090	Rotary Total Depth

Spudded in @ 4:30 p.m. November 8, 1975. Cut 210' of 12 1/4" hole. Ran 9 jts. of used 8 5/8" casing. Total 195.21'. Set @ 203'. Cemented with 150 sx. Common Cement, 3% ca. cl. Plug was down @ 12:30 a.m. November 9, 1975.
 Plugged and Abandoned: 1st Plug was set @ 1000' with 70 sx. cement; 2nd Plug was set @ 200' with 20 sx. cement; 3rd Plug was set @ 40' with 10 sx. cement. Plug was down @ 12:30 p.m. November 28, 1975. State Plugger: Gilbert Balthazor

SAMPLE TOPS:

Anhydrite 2212'
 B/Anhydrite 2256'

RECEIVED
 STATE CORPORATION COMMISSION

DEC 8 1975

12-8-75

STATE OF KANSAS)
) SS
 COUNTY OF SEDGWICK)

CONSERVATION DIVISION
 Wichita, Kansas

Jerry A. Langrehr, Executive Vice President of Abercrombie Drilling, Inc., does hereby state that the above and foregoing is a true and correct copy of the log of the Clark #1 NE NW NE Section 12-9S-25W, Graham County, Kansas.

ABERCROMBIE-DRILLING, INC.

By: Jerry A. Langrehr
 Jerry A. Langrehr-Exec. Vice President

Subscribed and sworn to before me, a Notary Public, in and for the aforesaid county and state as of this 5th day of December, 1975.

Margo Dee Montgomery
 Margo Dee Montgomery

My Commission Expires: July 21, 1979

