


WELL PLUGGING RECORD

15-065-21580-00-00

Give All Information Completely
 Make Required Affidavit

COUNTY Graham SEC. 16 TWP. 9S RGE. 25W E/W
 Location as in quarters or ~~footage~~ ~~from~~ lines:
 SE SE NE Sec. 16-~~600~~ FEL & ~~1930~~ FNL

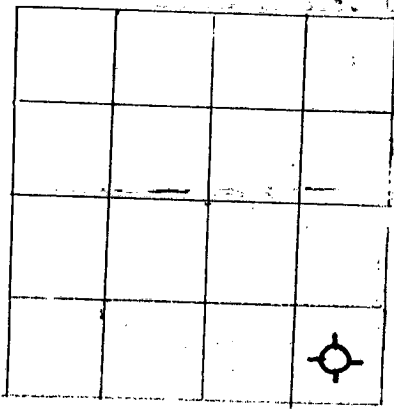

Locate Well
 correctly on above
 Section Platt.

Lease Owner Kissinger Exploration, Inc.
 Lease Name Simon Well No. 8-16
 Office Address 410 Seventeenth Street, Suite 850, Denver, CO 80202
 Character of Well (Completed as Oil, Gas or Dry Hole): Dry
 Date Well Completed 2/10/82
 Application for plugging filed _____
 Plugging commenced 2/10/82
 Plugging completed 2/10/82
 Reason for abandonment of well or producing formation Wildcat - dry

Was permission obtained from the Conservation Division or it's
 Agent's before plugging was commenced? Yes, verbal (Hamel)

Name of Conservation Agent who supervised plugging of this well _____
 Producing formation _____ Depth to top _____ bottom _____ T.D. 4140
 Show depth and thickness of all water, oil and gas formations.


OIL, GAS OR WATER RECORDS

Casing Record

| Formation | Content | From | To | Size | Put in | Pulled Out |
|-----------|---------|------|----|------|--------|------------|
| | | | | | | |
| | | | | | | |
| | | | | | | |
| | | | | | | |

Describe in detail the manner in which the well was plugged, indicating where the mud
 fluid was placed and the method or methods used in introducing it into the hold. If cement
 or other plugs were used, state the character of same and depth placed, from _____ feet
 to _____ feet for each plug set.

70 sacs at 1250'
40 sacs at 250'
10 sacs at 40' to ground level
10 sacs at rathole
5 sacs at mousehole
 Total 135 sacs 50/50 POS, 4% gel, 2% Calcium

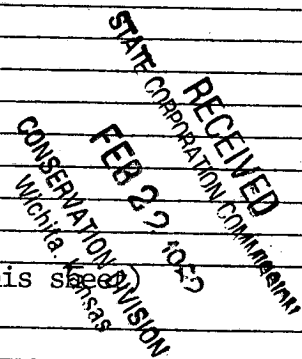

(If additional description is necessary, use BACK of this sheet)
 Name of Plugging Contractor _____

STATE OF Colorado COUNTY OF Denver, ss. 222-82
Kissinger Exploration, Inc. (employee of owner) or (owner or operator) of the
 above-described well, being first duly sworn on oath, says: That I have knowledge of the
 facts, statements, and matters herein contained and the log of the above-described well as
 filed and that the same are true and correct. So help me God.

(Signature) [Signature]
410 17th Street, Suite 850, Denver,
 (Address) _____ Colo.



SUBSCRIBED AND SWORN TO before me this 17th day of February, 19 82
Sheila M. Bielak
 My Commission expires: June 20, 1984 Sheila M. Bielak Notary Public.