


15-065-20699-00-00

STATE OF KANSAS
STATE CORPORATION COMMISSION

Give All Information Completely
Make Required Affidavit
Mail or Deliver Report to:
Conservation Division
State Corporation Commission
P. O. Box 17027
Wichita, Kansas 67217
NORTH

WELL PLUGGING RECORD

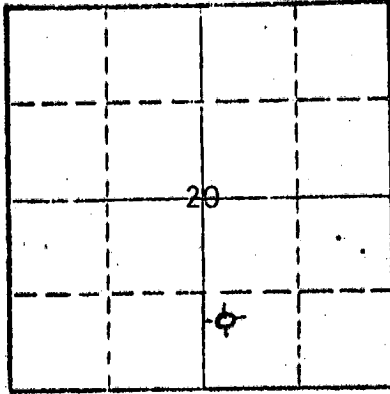

Locate well correctly on above Section Plot

GRAHAM County, Sec. 20 Twp. 9S Rge. (E) 25 (W) est
Location as "NE/CNW/SWK" or footage from lines NW SW SE
Lease Owner C-G DRILLING CO.
Lessee Name PFEIFER Well No. 1
Office Address 1107 UNION NATIONAL BLDG., WICHITA, KS 67202
Character of Well (completed as Oil, Gas or Dry Hole) DRY HOLE
Date well completed SEPTEMBER 3 19 74
Application for plugging filed SEPTEMBER 3 19 74
Application for plugging approved SEPTEMBER 3 19 74
Plugging commenced SEPTEMBER 3 19 74
Plugging completed SEPTEMBER 3 19 74
Reason for abandonment of well or producing formation TOO LOW STRUCTURALLY

If a producing well is abandoned, date of last production 19
Was permission obtained from the Conservation Division or its agents before plugging was commenced? YES

Name of Conservation Agent who supervised plugging of this well W L NICHOL, MORLAND, KANSAS
Producing formation _____ Depth to top _____ Bottom _____ Total Depth of Well 4121 Feet
Show depth and thickness of all water, oil and gas formations.

OIL, GAS OR WATER RECORDS

CASING RECORD

FORMATION	CONTENT	FROM	TO	SIZE	PUT IN	PULLED OUT
				8 5/8"	199.31'	None

Describe in detail the manner in which the well was plugged, indicating where the mud fluid was placed and the method or methods used in introducing it into the hole. If cement or other plugs were used, state the character of same and depth placed, from _____ feet to _____ feet for each plug set.

FILLED WITH HEAVY MUD TO 1325'. SET PLUG. PUT IN 70 SACKS CEMENT, FILLED WITH HEAVY MUD TO 215'. SET PLUG. PUT IN 20 SACKS CEMENT. FILLED WITH HEAVY MUD TO 40'. SET PLUG. FILLED TO TOP WITH 10 SACKS CEMENT.

RECEIVED
STATE CORPORATION COMMISSION

SEP 16 1974

CONSERVATION DIVISION
Wichita, Kansas

9-16-74

(If additional description is necessary, use BACK of this sheet)
Name of Plugging Contractor C-G DRILLING CO.
Address 1107 UNION NATIONAL BLDG., WICHITA, KANSAS 67202

STATE OF KANSAS, COUNTY OF SEDGWICK, ss.
G. F. Galloway (employee of owner) or (owner or operator) of the above-described well, being first duly sworn on oath, says: That I have knowledge of the facts, statements, and matters herein contained and the log of the above-described well as filed and that the same are true and correct. So help me God.

(Signature) G. F. Galloway
1107 Union National Bldg.
(Address)

Sworn to before me this 9th day of September, 1974



Phyllis Buchanan - Notary Public.