


15-065-00793-00-00

STATE OF KANSAS  
STATE CORPORATION COMMISSION

WELL PLUGGING RECORD

Give All Information Completely  
Make Required Affidavit  
Mail or Deliver Report to:  
Conservation Division  
State Corporation Commission  
211 No. Broadway  
Wichita, Kansas

NORTH

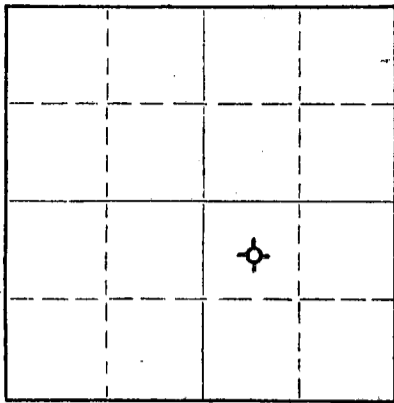

Locate well correctly on above  
Section Plat

Graham County, Sec. 21 Twp. 9S Rge. 25 (E) (W)W  
Location as "NE/CNW/SW" or footage from lines C NW SE  
Lease Owner C-G Drilling Co. & Petroleum Inc.  
Lease Name Dreiling "A" Well No. 1  
Office Address 107 Rule Building, Wichita, Kansas  
Character of Well (completed as Oil, Gas or Dry Hole) Dry Hole  
Date well completed December 11 19 59  
Application for plugging filed December 11 19 59  
Application for plugging approved December 11 19 59  
Plugging commenced December 11 19 59  
Plugging completed December 11 19 59  
Reason for abandonment of well or producing formation Too low structually

If a producing well is abandoned, date of last production 19  
Was permission obtained from the Conservation Division or its agents before plugging was commenced? Yes

Name of Conservation Agent who supervised plugging of this well Eldon Petty, Hays, Kansas  
Producing formation \_\_\_\_\_ Depth to top \_\_\_\_\_ Bottom \_\_\_\_\_ Total Depth of Well 4125 Feet  
Show depth and thickness of all water, oil and gas formations.

OIL, GAS OR WATER RECORDS

CASING RECORD

FORMATION	CONTENT	FROM	TO	SIZE	PUT IN	PULLED OUT
				8-5/8"	233.32'	None

Describe in detail the manner in which the well was plugged, indicating where the mud fluid was placed and the method or methods used in introducing it into the hole. If cement or other plugs were used, state the character of same and depth placed, from \_\_\_\_\_ feet to \_\_\_\_\_ feet for each plug set.

Filled hole with heavy mud to 500'. Set plug. Put in 20 sacks cement. Filled to 200'. Set plug. Put in 1/2 sack hulls and 20 sacks cement. Filled with heavy mud up to 40'. Set plug. Filled to top with 1/2 sack hulls and 10 sacks cement.

RECEIVED  
STATE CORPORATION COMMISSION

DEC 21 1959


CONSERVATION DIVISION  
Wichita, Kansas

Name of Plugging Contractor C-G Drilling Co. 12-21-59  
Address 107 Rule Building, Wichita 2, Kansas

STATE OF KANSAS, COUNTY OF SEDGWICK, ss.  
G. F. Galloway (employee of owner) or (owner or operator) of the above-described well, being first duly sworn on oath, says: That I have knowledge of the facts, statements, and matters herein contained and the log of the above-described well as filed and that the same are true and correct. So help me God.

(Signature) G. F. Galloway 107 Rule Building  
(Address)

SUBSCRIBED AND SWORN TO before me this 18th day of December, 19 59

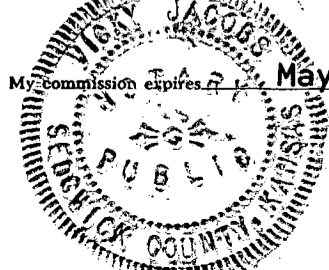

Vicky Jacobs  
Notary Public.

15-065-00793-00-00

W E L L L O G

OPERATOR C-G Drilling Co. & Petroleum Inc. SEC. 21-9S-25W  
 WELL NAME Dreiling "A" #1 LOC. C NW SE  
 TOTAL DEPTH 4125' COUNTY Graham  
 COMM. November 27, 1959 COMP. December 11, 1959 STATE Kansas  
 RIG NO. 2 ELEVATION 2609' R.B.  
 CASING: Ran 233.32' (11 jts.) 8-5/8" OD Surface Casing. PRODUCTION: D & A

All measurements taken from the top of rotary bushing.

FROM	TO	FORMATION	DEVIATION FROM VERTICAL	REMARKS:
0	1020	Shale-Shells		
1020	1320	Sand-Shale		
1320	1775	Shale-Shells	0° - 2500	
1775	2251	Red Bed	0° - 2750	
2251	2286	Anhydrite	0° - 3000	
2286	2640	Shale-Shells	0° - 3250	
2640	3642	Shale-Lime	0° - 3500	
3642	3702	Lime-Shale	0° - 3750	
3702	4125	Lime	0° - 4000	

RECEIVED  
STATE CORPORATION COMMISSION

DEC 21 1959

CONSERVATION DIVISION  
WICHITA, Kansas

12-21-59

STATE OF KANSAS }  
 COUNTY OF SEDGWICK } SS.

The undersigned hereby certifies that to the best of his knowledge and belief, the above facts are true and correct.

C-G DRILLING CO.

By G. F. Galloway  
G. F. Galloway

SUBSCRIBED AND SWORN TO, BEFORE ME, THIS 14th day of December, 1959.

My Commission expires:  
May 20, 1963

Vicky Jacobs  
Vicky Jacobs - Notary public

