

STATE CORPORATION COMMISSION OF KANSAS
OIL & GAS CONSERVATION DIVISION
WELL COMPLETION OR RECOMPLETION FORM
ACO-1 WELL HISTORY
DESCRIPTION OF WELL AND LEASE

Operator: License # 5146
Name Rains & Williamson Oil Co., Inc.
Address 220 West Douglas, Suite 435
Wichita, Kansas 67202
City/State/Zip

Purchaser

Operator Contact Person Juanita Green
Phone (316) 265-9686

Contractor: License # 5146
Name Rains & Williamson Oil Co., Inc.

Wellsite Geologist Dave Callewaert
Phone (316) 265-9686

Designate Type of Completion
 New Well Re-Entry Workover
 Oil SWD Temp Abd
 Gas Inj Delayed Comp.
 Dry Other (Core, Water Supply, etc.)

If ON/O: old well info as follows:
Operator
Well Name
Comp. Date Old Total Depth

WELL HISTORY

Drilling Method:
 Mud Rotary Air Rotary Cable
9-14-87 9-21-87 9-21-87
Spud Date Date Reached TD Completion Date
4160'
Total Depth PBTD
Amount of Surface Pipe Set and Cemented at 338 feet
Multiple Stage Cementing Collar Used? Yes No
If yes, show depth set feet
If alternate 2 completion, cement circulated from feet depth to w/ SX cmt
Cement Company Name
Invoice #

API NO. 15-179-20,907-00-00
County Sheridan
SE NE NE Sec. 27 Twp. 9S Rge. 26 West
4290 Ft. North from Southeast Corner of Section
330 Ft. West from Southeast Corner of Section
(Note: Locate well in section plat below)


Lease Name GEORGE SIMON Well # 1

Field Name Wildcat

Producing Formation

Elevation: Ground 2644 GL 2649 KB

Section Plat

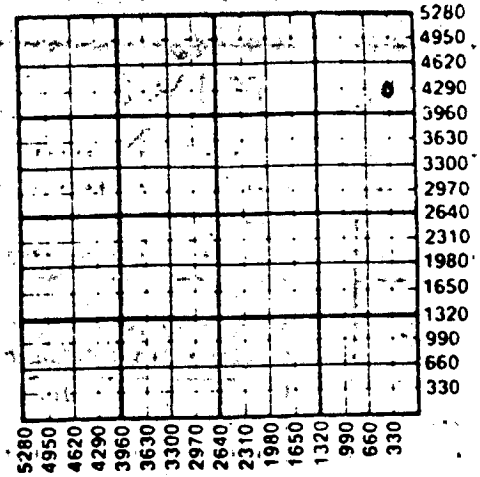

WATER SUPPLY INFORMATION

Disposition of Produced Water: Disposal Repressuring
Docket #

Questions on this portion of the ACO-1 call:

Water Resources Board (913) 296-3717
Source of Water:
Division of Water Resources Permit #
Groundwater.....Ft North from Southeast Corner (Well)Ft West from Southeast Corner of Sec Twp Rge East West
Surface Water.....Ft North from Southeast Corner (Stream, pond etc).....Ft West from Southeast Corner Sec Twp Rge East West
Other (explain).....
(purchased from city, R.W.D. #)


INSTRUCTIONS: This form shall be completed in triplicate and filed with the Kansas Corporation Commission, 200 Colorado Derby Building, Wichita, Kansas 67202, within 120 days of the spud date of any well. Rule 82-3-130, 82-3-107 and 82-3-106 apply. Information on side two of this form will be held confidential for a period of 12 months if requested in writing and submitted with the form. See rule 82-3-107 for confidentiality in excess of 12 months. One copy of all wireline logs and drillers time log shall be attached with this form. Submit CP-4 form with all plugged wells. Submit CP-111 form with all temporarily abandoned wells.

All requirements of the statutes, rules and regulations promulgated to regulate the oil and gas industry have been fully complied with and the statements herein are complete and correct to the best of my knowledge.

Signature Wilson Rains
Title PRESIDENT Date 9-24-87

Subscribed and sworn to before me this 24th day of September 1987
Notary Public Juanita M. Green
Date Commission Expires 10-4-87

K.C.C. OFFICE USE ONLY
 Letter of Confidentiality Attached
 Wireline Log Received
 Drillers Timelog Received
Distribution
 KCC SWD/Rep NGPA
 RECORDED Plug Other
STATE CORPORATION COMMISSION (Specify)
SEP 25 1987

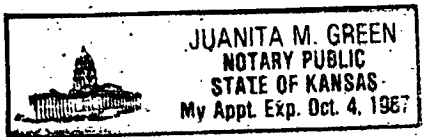

09-25-1987

Section 27 Twp 9 S Rge 26 W

Operator Name Rains & Williamson Oil Co., Inc. Lease Name GEORGE SIMON Well # 1

Sec. 27 Twp. 9S Rge. 26 East West County Sheridan

WELL LOG

INSTRUCTIONS: Show important tops and base of formations penetrated. Detail all cores. Report all drill stem tests giving interval tested, time tool open and closed, flowing and shut-in pressures, whether shut-in pressure reached static level, hydrostatic pressures, bottom hole temperature, fluid recovery, and flow rates if gas to surface during test. Attach extra sheet if more space is needed. Attach copy of log.

Drill Stem Tests Taken [X] Yes [] No
Samples Sent to Geological Survey [X] Yes [] No
Cores Taken [] Yes [X] No

Formation Description
[X] Log [] Sample

DST #1 3860' - 3912'. 30 45 60 60. Rec. 260' muddy water. IFP 32# - 64#, FFP 86# 108#. ISIP 1077#, FSIP 1055#. Temp. 115°.
DST #2 3919' - 3945'. 30 45 60 60. Rec. 750' muddy salt water with a good scum of oil on top. IFP 64# - 129#, FFP 83# - 291#. ISIP 1055#, FSIP Failed. Temp. 116°.
DST #3 4015' - 4112'. 30 30 30 30. Rec. 10' mud. IFP 32# - 32#, FFP 32# - 43#. ISIP 486#, FSIP 411#. Temp. 117°.

Table with 3 columns: Name, Top, Bottom. Rows include Anhydrite, B/Anhydrite, Topeka, Heebner, Lansing, B/KC, L.T.D.

CASING RECORD [] New [] Used
Report all strings set-conductor, surface, intermediate, production, etc.

Table with 8 columns: Purpose of String, Size Hole Drilled, Size Casing Set (in O.D.), Weight Lbs/Ft., Setting Depth, Type of Cement, #Sacks Used, Type and Percent Additives.

PERFORATION RECORD
Shots Per Foot | Specify Footage of Each Interval Perforated | Acid, Fracture, Shot, Cement Squeeze Record (Amount and Kind of Material Used) | Depth

TUBING RECORD Size Set At Packer at Liner Run [] Yes [] No

Date of First Production Producing Method [] Flowing [] Pumping [] Gas Lift [] Other (exp. in)
OCT 20 1988

Table with 4 columns: Oil, Gas, Water, Gas. Row: Estimated Production Per 24 Hours. Units: Bbls, MCF, Bbls, CFPB.

METHOD OF COMPLETION Production Interval

Disposition of gas: [] Vented [] Sold [] Used on Lease
[] Open Hole [] Perforation [] Other (Specify)
[] Dually Completed [] Commingled

RELEASED

FROM CONFIDENTIAL

DRILLER'S LOG

15-179-20007-00-00

COMPANY: Rains & Williamson Oil Co., Inc. SEC. 27 T. 9S R. 26W
 WELL NAME: GEORGE SIMON #1 LOC. SE NE NE
 COUNTY: Sheridan
 RIG NO. #9
 TOTAL DEPTH 4160' ELEVATION 2644 GL 2649 KB
 COMMENCED: 9-14-87 COMPLETED: 9-21-87
 CONTRACTOR: Rains & Williamson Oil Co., Inc.
 CASING RECORD:
 SURFACE: 8 5/8" @ 338' w/220 sx. 60-40 poz., 2% gel, 3% cc.
 PRODUCTION: D&A

LOG

(Figures Indicate Bottom of Formations)

Sand and Shale	2080
Shale and Shell	2291
Anhydrite	2340
Shale	3050
Shale and Lime	3330
Lime and Shale	4160
Rotary Total Depth	4160

RELEASED
 OCT 20 1987
 FROM CONFIDENTIAL

STATE OF KANSAS)
 COUNTY OF SEDGWICK) SS:

I, WILSON RAINS, PRESIDENT of RAINS & WILLIAMSON OIL CO., INC.
 upon oath state that the above and foregoing is a true and correct copy of the log of the
GEORGE SIMON #1 well.



KANSAS GEOLOGICAL SURVEY
 WICHITA BRANCH

SEP 26 1987

Wilson Rains
 WILSON RAINS

Subscribed and sworn to before me this 24th day of September, 1987.

My Appointment Expires:
10-4-87

Juanita M. Green
 SEP 26 1987
 Juanita M. Green - Notary Public