

15-179-30176-00-00


RECEIVED
01-28-1937
4a
Strike out upper line when reporting plugging off formations.

STATE OF KANSAS
STATE CORPORATION COMMISSION

WELL PLUGGING RECORD
OR
FORMATION PLUGGING RECORD

Give All Information Completely
Make Required Affidavit
Mail or Deliver Report to:
Conservation Division
State Corporation Commission,
800 Bittling Building,
Wichita, Kansas

Sheridan County, Sec. 34 Twp. 9 Rge. 26 (E) (WX)
Location as "NE 1/4 NW 1/4 SW 1/4" or footage from lines Center of NW 1/4

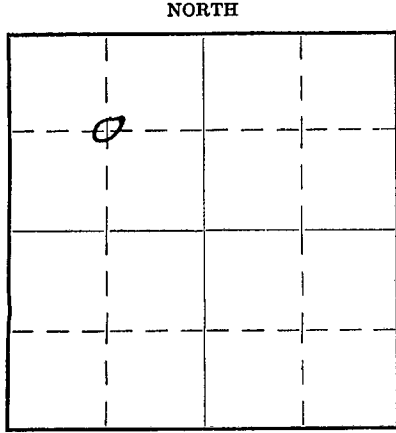

Locate well correctly on above Section Plat

Lease Owner Roberts and Murray
Lease Name Corrick Well No. one
Office Address 618 Commerce Exchange Bldg. Oklahoma City, Okla.
Character of Well (Completed as Oil, Gas or Dry Hole) dry hole
Date, well completed January 19 1937
Application for plugging filed January 19 1937
Application for plugging approved January 19 1937
Plugging Commenced January 20 1937
Plugging Completed January 20 1937
Reason for abandonment of well or producing formation dry hole

If a producing well is abandoned, date of last production 193...
Was permission obtained from the Conservation Division or its agents before plugging was commenced? yes

Name of Conservation Agent who supervised plugging of this well C. T. Alexander
Producing formation none Depth to top Bottom Total Depth of Well 4664 Feet
Show depth and thickness of all water, oil and gas formations.

OIL, GAS OR WATER RECORDS CASING RECORD

Formation	Content	From	To	Size	Put In	Pulled Out
				15 1/2	122ft	none

Describe in detail the manner in which the well was plugged, indicating where the mud fluid was placed and the method or methods used in introducing it into the hole. If cement or other plugs were used, state the character of same and depth placed, from... feet to... feet for each plug set.
Filled with heavy rotary mud to 124 ft. put in cement plug to 109 ft. filled with heavy mud to 15 ft. filled with cement to surface.
This mud was pumped into hole. Cement was dumped into hole.

PLUGGING
FILE SEC 34 T 9 R 26 E
JAN 27 1937
OKLAHOMA CITY
PLUGGING

(If additional description is necessary use BACK of this sheet)
Correspondence regarding this well should be addressed to Otis A. Roberts
Address 618 Commerce Exchange Bldg., Oklahoma City, Okla.

STATE OF Kansas, COUNTY OF Trego, ss.
Dewey E. Waggoner (employee of owner) or (owner or operator) of the above-described well, being first duly sworn on oath, says: That I have knowledge of the facts, statements, and matters herein contained and the log of the above-described well as filed and that the same are true and correct. So help me God.

(Signature) Dewey E. Waggoner
(Address) Wagoner, Kans.

SUBSCRIBED AND SWORN to before me this 22nd day of January, 1937

My commission expires Feb. 11th 1938

Notary Public.


15-179 - 30176-00-00

LOG OF WELL

ROBERTS & MURRAY
CORRICK NO. I

- CENTER OF -
NW $\frac{1}{4}$ OF SEC. 34 - T. 9S - R. 26W
Sheridan County, Kansas

Total Depth - 4664
Comm. 10-24-36 Comp. 1-20-37
Shot or Treated - No
Contractor - C. M. Murray
Production - DRY

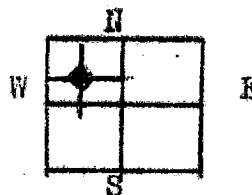

DEPTH		- FORMATION -	DEPTH		- FORMATION -
From	To		From	To	
0	124	Set 15 $\frac{1}{2}$ " Csg.	3084	3182	Broken Lime
124	588	Sandy Shale	3182	3406	Lime
588	733	Shale	3406	3414	Shale
733	948	Shale and Shells	3414	3433	Shale and Shells
948	1112	Shale	3433	3476	Shale
1112	1231	Dakota Sand	3476	3528	Shale and Lime
1231	1425	Shale and Sand	3528	3658	Lime
1425	1602	Sand and Shells	3658	3661	Sand
1602	1663	Shale and Sand	3661	3982	Lime
1663	1710	Shale	3982	3985	Broken Lime
1710	1735	Lime	3985	4020	Lime
1735	1748	Broken Lime	4020	4031	Chirty Lime
1748	1940	Red Bed and Broken Lime Shells	4031	4174	Lime
1940	2083	Red Bed	4174	4309	Broken Lime
2083	2186	Red Bed and Shale	4309	4405	Lime
2186	2268	Red Bed and Shells	4405	4444	Broken Lime
2268	2310	Shale and Lime Shells	4444	4459	Lime
2310	2403	Shale Shells	4459	4489	Chat
2403	2483	Red Shale and G yp	4489	4541	Lime
2482	2573	Shale and Gyp (Red Shale)	4541	4585	Lime (Broken)
2573	2638	Shale and Gyp	4585	4600	Broken Lime
2638	2734	Shells and Gyp	4600	4619	Lime
2734	2782	Lime	4619	<u>4664</u>	Broken Lime
2782	2888	Shale and Shells			
2888	3084	Lime			

PLUGGING
SEC 34 9 - R. 26W
BOOK PAGE 77 LINE 9