


Give All Information Completely
Make Required Affidavit
Mail or Deliver Report to:
Conservation Division
State Corporation Commission
P. O. Box 17027
Wichita, Kansas 67217
NORTH

WELL PLUGGING RECORD

Sheridan County, Sec. 5 Twp. 9S Rge. (E) 27(W)
Location as "NE/CNW/SW" or footage from lines NW SW NW
Lease Owner Rains & Williamson Oil Co., Inc.
Lease Name Kennedy Well No. #1
Office Address 435 Page Court, 220 W. Douglas, Wichita, Kansas 67202
Character of Well (completed as Oil, Gas or Dry Hole) Dry Hole
Date well completed 3-21-77 19
Application for plugging filed 3-21-77 19
Application for plugging approved 3-21-77 19
Plugging commenced 3-21-77 19
Plugging completed 3-21-77 19
Reason for abandonment of well or producing formation Commercial quantities of oil not found.
If a producing well is abandoned, date of last production 19
Was permission obtained from the Conservation Division or its agents before plugging was commenced? Yes

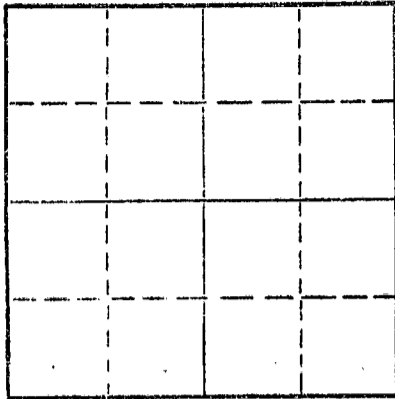

Locate well correctly on above Section Plat

Name of Conservation Agent who supervised plugging of this well Gilbert Balthazor, Palco, Kansas
Producing formation _____ Depth to top _____ Bottom _____ Total Depth of Well 4025' Feet
Show depth and thickness of all water, oil and gas formations.

OIL, GAS OR WATER RECORDS

CASING RECORD

FORMATION	CONTENT	FROM	TO	SIZE	PUT IN	PULLED OUT
				8 5/8"	323'	None

Describe in detail the manner in which the well was plugged, indicating where the mud fluid was placed and the method or methods used in introducing it into the hole. If cement or other plugs were used, state the character of same and depth placed, from _____ feet to _____ feet for each plug set.

Plug @ 1100' w/70 sx.
Plug @ 300' w/40 sx.
Plug @ 40' w/10 sx.

MAAD 301911
03-30-1977
Wichita, Kansas


(If additional description is necessary, use BACK of this sheet)

Name of Plugging Contractor Rains & Williamson Oil Co., Inc.
Address 435 Page Court, 220 W. Douglas, Wichita, Kansas 67202

STATE OF Kansas, COUNTY OF Sedgwick, ss.
Wilson Rains, President of Rains & Williamson Oil Co., Inc. (employee of owner) or (owner or operator) of the above-described well, being first duly sworn on oath, says: That I have knowledge of the facts, statements, and matters herein contained and the log of the above-described well as filed and that the same are true and correct. So help me God.

(Signature) Wilson Rains
435 Page Court, 220 W. Douglas, Wichita, Ks. 67202
(Address)

SUBSCRIBED AND SWORN to before me this 29 day of March, 1977

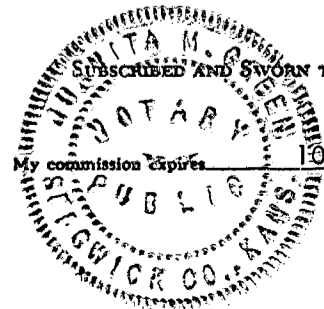

Juanita M. Green
Notary Public.

DRILLER'S LOG

15-179-20447-00-00

COMPANY: Rains & Williamson Oil Co., Inc. SEC. 5 T. 9S R. 27W
WELL NAME: Kennedy #1 COUNTY: Sheridan

RIG NO. #4

TOTAL DEPTH 4025' ELEVATION 2629 KB

COMMENCED: 3-13-77 COMPLETED: 3-21-77

CONTRACTOR: Rains & Williamson Oil Co., Inc.

CASING RECORD:

SURFACE: 8 5/8" @ 323' w/225 sx. 50/50 poz., 2% gel, 3% cc.

PRODUCTION: D&A

LOG

(Figures Indicate Bottom of Formations)

Sand & Shale	330
Shale	912
Shale & Shells	1730
Shale, Sand & Shale	1880
Sand, Shale & Redbed	2089
Redbed & Shale	2238
Shale	2645
Shale & Redbed	2795
Redbed & Shale	2945
Shale	3130
Shale & Redbed	3293
Shale & Lime	3550
Lime	3703
Lime & Shale	3764
Lime	4025
<u>ROTARY TOTAL DEPTH</u>	<u>4025</u>

RECEIVED
STATE CORPORATION COMMISSION

MAR 30 1977
03-30-1977
CONSERVATION DIVISION
Wichita, Kansas

STATE OF Kansas)
COUNTY OF Sedgwick) SS:

I, Wilson Rains, President of Rains & Williamson Oil Co., Inc.
upon oath state that the above and foregoing is a true and correct copy of the log of the
Kennedy #1 well.

Wilson Rains
Wilson Rains

Subscribed and sworn to before me this 29 day of March, 1977.

My Appointment Expires:
10-4-79

Juanita M. Green
Juanita M. Green

