


WELL PLUGGING RECORD

15-179-20671-00-00

Give All Information Completely  
 Make Required Affidavit

COUNTY Sheridan SEC. 12 TWP. 9S RGE. 27 ~~E/W~~  
 Location as in quarters or footage from lines:  
165' E of SE SW SE

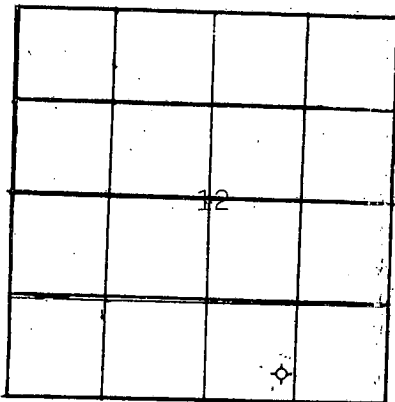

Locate Well  
 correctly on above  
 Section Platt.

Lease Owner Petroventures, Inc.  
 Lease Name Breeden Well No. 2  
 Office Address 4704 Harlan, Suite 600, Denver, CO 80212  
 Character of Well (Completed as Oil, Gas or Dry Hole)  
 Date Well Completed January 15, 1983  
 Application for plugging filed January 15, 1983  
 Plugging commenced January 15, 1983  
 Plugging completed January 15, 1983

Reason for abandonment of well or producing formation  
dry hole

Was permission obtained from the Conservation Division or it's  
 Agent's before plugging was commenced? yes

Name of Conservation Agent who supervised plugging of this well Marian Schmidt  
 Producing formation \_\_\_\_\_ Depth to top \_\_\_\_\_ bottom \_\_\_\_\_ T.D. 4,120

Show depth and thickness of all water, oil and gas formations.

OIL, GAS OR WATER RECORDS

Casing Record

Formation	Content	From	To	Size	Put in	Pulled Out.
				8-5/8"	322	--

Describe in detail the manner in which the well was plugged, indicating where the mud  
 fluid was placed and the method or methods used in introducing it into the hold. If cement  
 or other plugs were used, state the character of same and depth placed, from \_\_\_\_\_ feet  
 to \_\_\_\_\_ feet for each plug set.

Mud to 2,280', 20 sx cement  
 Mud to 1,440', 100 sx cement  
 Mud to 315', 40sx cement  
 Mud to 40', plug, 10 sx cement  
 10 sx cement in rathole  
 50/50 posmix, 6% gel, 3% cal

RECEIVED  
 STATE CORPORATION COMMISSION  
 01-24-1983  
 JAN 24 1983  
 CONSERVATION DIVISION  
 Wichita Kansas

(If additional description is necessary, use BACK of this sheet)  
 Name of Plugging Contractor \_\_\_\_\_

STATE OF KANSAS COUNTY OF SEDGWICK, ss.  
Donald E. Hunt (employee of owner) ~~owner or operator~~ of the  
 above-described well, being first duly sworn on oath, says: That I have knowledge of the  
 facts, statements, and matters herein contained and the log of the above-described well as  
 filed and that the same are true and correct. So help me God.

(Signature) Donald E. Hunt  
 Suite 250, 200 W. Douglas  
 Wichita, (Address) Kansas  
 67202

Kathleen L. Greger  
 Kathleen L. Greger, Notary Public.



SUBSCRIBED AND SWORN TO before me this 18th day of January, 19 83  
 My Commission expires: January 20, 1985