


STATE OF KANSAS  
STATE CORPORATION COMMISSION

15-179-00188-00-00

WELL PLUGGING RECORD

Give All Information Completely  
Make Required Affidavit  
Mail or Deliver Report to:  
Conservation Division  
State Corporation Commission  
800 Biting Building  
Wichita, Kansas

Sheridan County, Sec. 22 Twp. 9S Rge. 27 (E) W (W)  
Location as "NE/CNW%SW%" or footage from lines SW/4 SW/4 NW/4  
Lease Owner Heathman-Seeligson Drilling Co.  
Lease Name Albert Well No. 1  
Office Address 1015 E. Second, Wichita, Kansas  
Character of Well (completed as Oil, Gas or Dry Hole) Dry Hole  
Date well completed 12-16- 19 56  
Application for plugging filed 12-16- 19 56  
Application for plugging approved 12-16- 19 56  
Plugging commenced 12-16- 19 56  
Plugging completed 12-16- 19 56  
Reason for abandonment of well or producing formation  
Twisted off unrecovered fish at 2141 feet.  
If a producing well is abandoned, date of last production ---- 19 ---  
Was permission obtained from the Conservation Division or its agents before plugging was commenced? yes

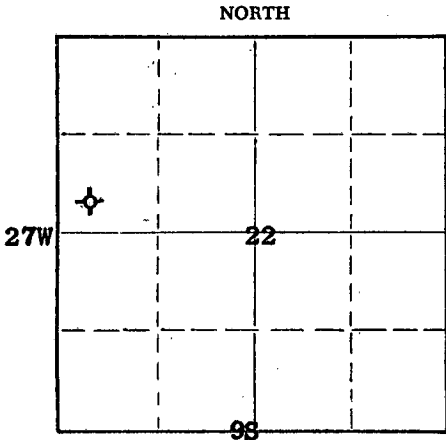

Locate well correctly on above Section Plat

Name of Conservation Agent who supervised plugging of this well Eldon Petty, Box 326, Hays, Kansas  
Producing formation ----- Depth to top --n Bottom ----- Total Depth of Well 2141 Feet  
Show depth and thickness of all water, oil and gas formations.

OIL, GAS OR WATER RECORDS CASING RECORD

FORMATION	CONTENT	FROM	TO	SIZE	PUT IN	PULLED OUT
-----	-----	-----	---	8-5/8" used	surf. csg.	
				cemented at	247.36	
				w/200 sx. of sx.		
				cement, 3 Calcium		
				Chloride, 2% Gel.		

Describe in detail the manner in which the well was plugged, indicating where the mud fluid was placed and the method or methods used in introducing it into the hole. If cement or other plugs were used, state the character of same and depth placed, from \_\_\_\_\_ feet to \_\_\_\_\_ feet for each plug set.

Went in hole with drillpipe. Filled hole with heavy mud to 240'. Set plug at 240'. Put 1/2 sack hulls and 15 sacks cement on top of same. Filled hole to 40'. Set plug and put 10 sacks cement on top of same.  
Skidded rig 10 feet toward west line.

(If additional description is necessary, use BACK of this sheet)

Name of Plugging Contractor Heathman-Seeligson Drilling Co.  
Address 1015 E. Second, Wichita, Kansas

STATE OF Kansas, COUNTY OF Sedgwick, ss.  
H. D. Shreve (employee of owner) of the above-described well, being first duly sworn on oath, says: That I have knowledge of the facts, statements, and matters herein contained and the log of the above-described well as filed and that the same are true and correct. So help me God.

(Signature) By: [Signature]  
1015 E. Second, Wichita, Kansas  
(Address)

SUBSCRIBED AND SWORN to before me this 9th day of January, 19 57  
My commission expires April 3, 1960  
Patricia W. Lanikin Notary Public.



PLUGGING  
FILE SEC 22 T 9 R 27W  
BOOK PAGE 127 LI E 21

RECEIVED  
STATE CORPORATION COMMISSION  
JAN 17 1957  
CONSERVATION DIVISION  
Wichita, Kansas

15-179-00188-00-00

DRILLERS' LOG

NAME:	ALBERT #1	DATE SPUDDED:	12-10-56
LOCATION:	SW/4 SW/4 NW/4 Sec.22-9S-27W Sheridan County, Kansas	ROTARY COMPLETED:	12-16-56
OPERATOR:	Heathman-Seeligson Drilling Co.	ELEVATION:	2716 GR 2718 DF 2721 KB
CONTRACTOR:	Heathman-Seeligson Drilling Co.	ROTARY TOTAL DEPTH:	2141'
SURFACE CASING:	Ran 12 jts. of 8-5/8" used casing cemented at 247.36' with 200 sacks cement and 3 Calcium Chloride.		
OIL STRING:	None run.		

GEOLOGICAL TOPS

None

L O G

(Figures indicate bottom of formation)


Clay & Sand	0 - 120
Sand	210
Shale	247
Shale & Sand	1000
Shale & Shells	1400
Sand & Shale	1510
Shale & Shells	1550
Shale, Lime & Shells	1750
Shale & Shells	1805
Anhydrite	1845
Shale, Shells & Red Bed	2020
Shale & Red Bed	2141

The undersigned, H. D. Shreve, hereby certifies that the above log is a true and correct log of the formations encountered in drilling the above noted well as reflected by the Daily Drilling Report.

HEATHMAN-SEELIGSON DRILLING CO.

By: 

Subscribed and sworn to before me the 9th day of January, 1957.

  
Patricia W. Lanekin, Notary Public

My commission expires: April 3, 1960

PLUGGING	
FILE SEC 22 T. 9 R 27W	
BOOK P/C 127 LINE 21	

RECEIVED  
STATE CORPORATION COMMISSION

JAN 17 1957  
06-17-1957  
CONSERVATION DIVISION  
Wichita, Kansas