


WELL PLUGGING RECORD

Give All Information Completely  
Make Required Affidavit  
Mail or Deliver Report to:  
Conservation Division  
State Corporation Commission  
212 No. Market  
Wichita, Kansas

NORTH

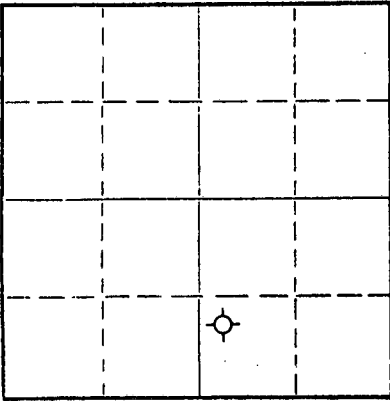

Locate well correctly on above Section Plat

Sheridan

County. Sec. 13 Twp. 9S Rge. (E) 28 (W)

Location as "NE/CNW%SW%" or footage from lines. NW SW SE  
Lease Owner Glen Rupe  
Lease Name Ochs Well No. B-1  
Office Address Brown Building, Wichita, Kansas  
Character of Well (completed as Oil, Gas or Dry Hole) dry hole  
Date well completed 4-12-69 19  
Application for plugging filed 4-12-69 19  
Application for plugging approved 4-12-69 19  
Plugging commenced 4-12-69 19  
Plugging completed 4-12-69 19  
Reason for abandonment of well or producing formation dry hole

If a producing well is abandoned, date of last production \_\_\_\_\_ 19\_\_\_\_  
Was permission obtained from the Conservation Division or its agents before plugging was commenced? yes

Name of Conservation Agent who supervised plugging of this well W. L. Nichols, Morland, Kansas  
Producing formation \_\_\_\_\_ Depth to top \_\_\_\_\_ Bottom \_\_\_\_\_ Total Depth of Well 4170 Feet  
Show depth and thickness of all water, oil and gas formations.

OIL, GAS OR WATER RECORDS

CASING RECORD

FORMATION	CONTENT	FROM	TO	SIZE	PUT IN	PULLED OUT

Describe in detail the manner in which the well was plugged, indicating where the mud fluid was placed and the method or methods used in introducing it into the hole. If cement or other plugs were used, state the character of same and depth placed, from \_\_\_\_\_ feet to \_\_\_\_\_ feet for each plug set.

Filled hole to 1500 feet with heavy mud. Set plug and  $\frac{1}{4}$  sack rolled tied hulls at 1500 feet. Cemented hole with 100 sacks through drill pipe. Filled hole to 270 ft. with heavy mud. Set plug at 270 feet. Cemented hole with 20 sacks through drill pipe. Filled hole to 40 feet with heavy mud. Dumped  $\frac{1}{2}$  sacks hulls on fluid at 40 feet. Dumped  $\frac{1}{2}$  sack dry cement on hulls. Pushed  $\frac{1}{4}$  sack hulls rolled and tied on top of bridge. Cemented top of hole with 10 sacks cement. Bridge rat hole and cemented with two sacks cement three feet below ground level.

RECEIVED  
STATE CORPORATION COMMISSION  
APR 17 1969  
CONSERVATION DIVISION  
Wichita, Kansas  
04-17-1969

(If additional description is necessary, use BACK of this sheet)  
Name of Plugging Contractor American Drilling Co., Ltd  
Address 360 Sutton Place, Wichita, Kansas

STATE OF Kansas, COUNTY OF Sedgwick, ss.  
Larry G. Stephenson (employee of owner) or (owner or operator) of the above-described well, being first duly sworn on oath, says: That I have knowledge of the facts, statements, and matters herein contained and the log of the above-described well as filed and that the same are true and correct. So help me God.

(Signature) Larry G. Stephenson  
360 Sutton Place, Wichita, Kansas  
(Address)

SUBSCRIBED AND SWORN TO before me this 15 day of April, 1969

My commission expires July 25, 1972

Marjorie Stephenson  
Notary Public.

15-179-20195-00-00

COMPANY: Glen Rupe  
CONTRACTOR: American Drilling Co., Ltd  
FARM: Ochs B-1  
LOCATION: Section 13-9S-28W, Sheridan County  
NW SW SE  
COMMENCED: March 27, 1969  
COMPLETED: April 12, 1969

---

0	to	241	Shale
241	to	1300	Shale & Shells
1300	to	1990	Shale
1990	to	2585	Red Bed
2585	to	2705	Red Bed & Shale
2705	to	2805	Shale
2805	to	2980	Shale & Chalk
2980	to	3085	Shale
3085	to	3265	Lime & Shale
3265	to	3314	Lime
3314	to	3450	Shale & Lime
3450	to	3573	Lime
3573	to	3635	Lime & Shale
3635	to	4170	Lime
		4170	Total Depth

---

RECEIVED  
STATE CORPORATION COMMISSION  
APR 17 1969  
CONSERVATION DIVISION  
Wichita, Kansas  
04-17-1969

Set 238 feet of 8 5/8" surface pipe w/225 sx, Sunset.

Dry and Abandoned

---

CERTIFICATE

I, Larry G. Stephenson, do hereby certify that the above and foregoing is a true and correct copy of the drillers log of the Ochs #B-1, Section 13-9S-28W, Sheridan County, Kansas as reflected by files of the American Drilling Co., Ltd.

  
Larry G. Stephenson