


WELL PLUGGING RECORD

Give All Information Completely  
Make Required Affidavit  
Mail or Deliver Report to:  
Conservation Division  
State Corporation Commission  
211 No. Broadway  
Wichita, Kansas

Sheridan County, Sec. 26 Twp. 9S Rge. 28 ~~XXXX~~ (W) X

NORTH

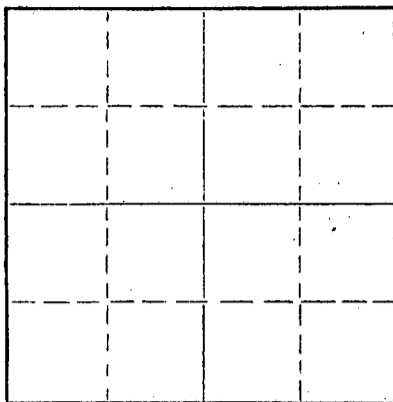

Locate well correctly on above  
Section Plat

Location as "NE/CNW/SW" or footage from lines C SE NW  
Lease Owner Empire Drilling Company  
Lease Name Westphal Well No. 1  
Office Address 650 Fourth National Bank Building, Wichita, Kansas  
Character of Well (completed as Oil, Gas or Dry Hole) Dry Hole  
Date well completed May 19, 1959 19  
Application for plugging filed May 19, 1959 19  
Application for plugging approved May 19, 1959 19  
Plugging commenced May 19, 1959 19  
Plugging completed May 19, 1959 19  
Reason for abandonment of well or producing formation Dry Hole

If a producing well is abandoned, date of last production \_\_\_\_\_ 19  
Was permission obtained from the Conservation Division or its agents before plugging was commenced? Yes

Name of Conservation Agent who supervised plugging of this well A. D. Fabricius  
Producing formation \_\_\_\_\_ Depth to top \_\_\_\_\_ Bottom \_\_\_\_\_ Total Depth of Well 4155 Feet  
Show depth and thickness of all water, oil and gas formations.

OIL, GAS OR WATER RECORDS

CASING RECORD

FORMATION	CONTENT	FROM	TO	SIZE	PUT IN	PULLED OUT
	Surface	0	243	8 5/8"	243'	

Describe in detail the manner in which the well was plugged, indicating where the mud fluid was placed and the method or methods used in introducing it into the hole. If cement or other plugs were used, state the character of same and depth placed, from \_\_\_\_\_ feet to \_\_\_\_\_ feet for each plug set.

Plug set @ 600' w/ 20 sx cement  
Plug set @ 240' w/ 20 sx cement  
Plug set @ 40' w/ 10 sx cement

RECEIVED  
MAY 27 1959  
15-179-00140-00-00  
CONSERVATION DIVISION  
Wichita, Kansas

(If additional description is necessary, use BACK of this sheet)

Name of Plugging Contractor Empire Drilling Company  
Address 650 Fourth National Bank Building, Wichita, Kansas


STATE OF KANSAS, COUNTY OF SEDGWICK, ss.  
Dan J. Kornfeld (owner or operator) of the above-described well, being first duly sworn on oath, says: That I have knowledge of the facts, statements, and matters herein contained and the log of the above-described well as filed and that the same are true and correct. So help me God.

(Signature) Dan J. Kornfeld  
650 Fourth National Bank Bldg., Wichita, Kansas  
(Address)

Subscribed and Sworn to before me this 26th day of MAY May, 19 59

Charlotte Stanley  
Charlotte Stanley Notary Public.

My commission expires June 7, 1960

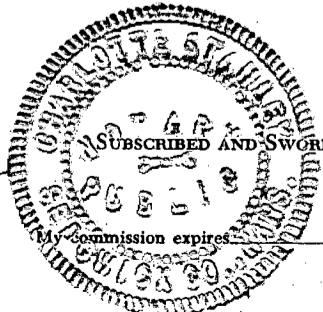

PLUGGING  
FILE SEC 26 T 9 R 28  
BOOK PAGE 41 LINE 19