

STATE CORPORATION COMMISSION OF KANSAS
OIL & GAS CONSERVATION DIVISION

WELL COMPLETION OR RECOMPLETION FORM
ACO-1 WELL HISTORY

DESCRIPTION OF WELL AND LEASE

Operator: License # 5140
Name Frontier Oil Company
Address 125 N. Market, Ste 1720
Wichita, Ks. 67202
City/State/Zip

Purchaser N/A

Operator Contact Person Jean Angle
Phone 316-263-1201

Contractor: License # 5302
Name Red Tiger Drilling Company

Wellsite Geologist Richard Parker
Phone 913-483-5348

Designate Type of Completion

- New Well Re-Entry Workover
- Oil SWD Temp Abd
- Gas Inj Delayed Comp.
- Dry Other (Core, Water Supply etc.)

If OWMO: old well info as follows:

Operator
Well Name
Comp. Date Old Total Depth

WELL HISTORY

Drilling Method:

- Mud Rotary Air Rotary Cable

6-10-85 6-18-85 6-19-85
Spud Date Date Reached TD Completion Date
4210' N/A
Total Depth PBDT

Amount of Surface Pipe Set and Cemented at 259 feet
Multiple Stage Cementing Collar Used? Yes No
If yes, show depth set feet
If alternate 2 completion, cement circulated from feet depth to w/ SX cmt

API NO. 15-179-20.827-00-00

County Sheridan

C-S/2 S/2 NE/4 Sec. 30 Twp. 9S Rge. 28W East West

2970' Ft North from Southeast Corner of Section
1320' Ft West from Southeast Corner of Section

(Note: Locate well in section plat below)


Lease Name Adams Well # 2

Field Name (Wildcat)

Producing Formation N/A

Elevation: Ground 2817' KB 2822'

Section Plat

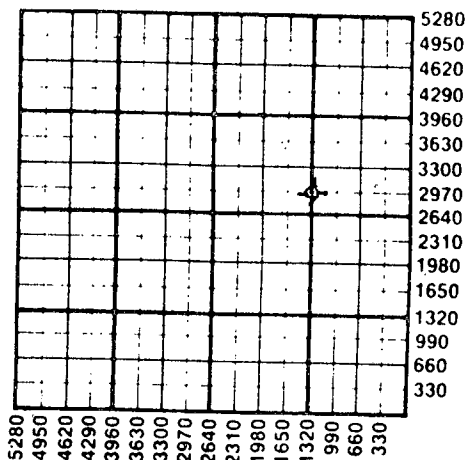

WATER SUPPLY INFORMATION

Disposition of Produced Water: N/A Disposal Repressuring
Docket #

Questions on this portion of the ACO-1 call:

Water Resources Board (913) 296-3717

Source of Water: Oliver Kramawitter, Hoxie, Ks.
Division of Water Resources Permit #

Groundwater NW/4 Ft North from Southeast Corner
(Well) Ft West from Southeast Corner of
Sec 30 Twp 9S Rge 28 East West

Surface Water Ft North from Southeast Corner
(Stream, pond etc) Ft West from Southeast Corner
Sec Twp Rge East West


Other (explain)
(purchased from city, R.W.D. #)

INSTRUCTIONS: This form shall be completed in duplicate and filed with the Kansas Corporation Commission, 200 Colorado Derby Building, Wichita, Kansas 67202, within 90 days after completion or recompletion of any well. Rule 82-3-130 and 82-3-107 apply. Information on slide two of this form will be held confidential for a period of 12 months if requested in writing and submitted with the form. See rule 82-3-107 for confidentiality in excess of 12 months. One copy of all wireline logs and drillers time log shall be attached with this form. Submit CP-4 form with all plugged wells. Submit CP-111 form with all temporarily abandoned wells.

All requirements of the statutes, rules and regulations promulgated to regulate the oil and gas industry have been fully complied with and the statements herein are complete and correct to the best of my knowledge.

Signature Jean Angle
Title Agent Date 7-15-85

K.C.C. OFFICE USE ONLY
 Letter of Confidentiality Attached
 Wireline Log Received
 Drillers Timelog Received
Distribution
 KCC SWD/Rep NGPA
 KGS Plug Other (Specify)

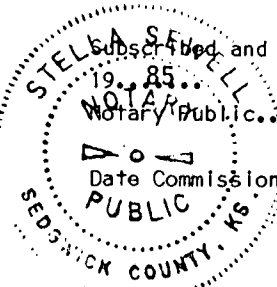

Date Commission Expires June 24, 1988

Sec. 30 Twp. 9S Rge. 28W

Operator Name Frontier Oil Company Lease Name Adams Well # 2

Sec 30 Twp 9S Rge 28W East West County Sheridan

WELL LOG

INSTRUCTIONS: Show important tops and base of formations penetrated. Detail all cores. Report all drill stem tests giving interval tested, time tool open and closed, flowing and shut-in pressures, whether shut-in pressure reached static level, hydrostatic pressures, bottom hole temperature, fluid recovery, and flow rates if gas to surface during test. Attach extra sheet if more space is needed. Attach copy of log.

Drill Stem Tests Taken [X] Yes [] No
Samples Sent to Geological Survey [] Yes [X] No
Cores Taken [] Yes [X] No

Formation Description [] Log [X] Sample

DST 1 (4098-4130) 60-30-30-30 1st op wk inc to fr 2nd op fr blo. Rec 170' SW, 10'M IF 72-103 FF 82-123 ISI 1216 FSI 1186

DST 2 (4128-4150) Packer failure.

DST 3 (4098-4150) 60-30-30-30. 1st op wk bldg blo 2nd op wk bldg blo. Rec 250' WM IF 82-144 FF 165-206 ISIP 1236 FSIP 1216.

Table with 3 columns: Name, Top, Section. Rows include Anhydrite, Howard, Topeka, Heebner, Toronto, Lansing, Base KC, and RTD.

RTD 4210'

Plugged.

CONFIDENTIAL

Form sections: CASING RECORD, PERFORATION RECORD, TUBING RECORD, Date of First Production, Estimated Production, METHOD OF COMPLETION.

OCT 03 1986

FROM CONFIDENTIAL

Disposition of gas: [] Vented [] Open Hole [] Perforation [] Sold [] Other (Specify) [] Used on Lease

[] Dually Completed [] Commingled