


WELL PLUGGING RECORD

Give All Information Completely
Make Required Affidavit
Mail or Deliver Report to:
Conservation Division
State Corporation Commission
800 Bitting Building
Wichita, Kansas

Sheridan County. Sec. 28 Twp. 9S Rge. (E) 29(W)
Location as "NE/CNW&SW¼" or footage from lines 330' NSL & 330' WEL. of SW¼
Lease Owner Gulf Oil Corporation
Lease Name Manhart Well No. 1
Office Address Box 661, Tulsa, Oklahoma
Character of Well (completed as Oil, Gas or Dry Hole) Dry Hole
Date well completed 4-5 19 55
Application for plugging filed 4-6 19 55
Application for plugging approved 4-6 19 55
Plugging commenced 4-6 19 55
Plugging completed 4-7 19 55
Reason for abandonment of well or producing formation Dry Hole

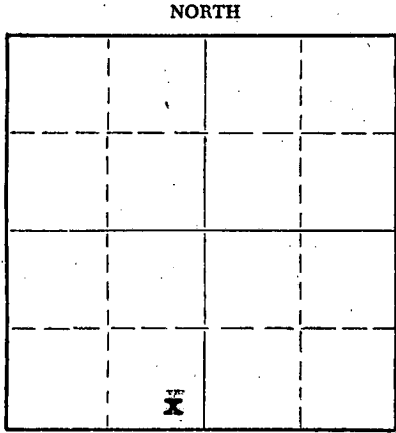

Locate well correctly on above Section Plat

If a producing well is abandoned, date of last production 19
Was permission obtained from the Conservation Division or its agents before plugging was commenced? Yes

Name of Conservation Agent who supervised plugging of this well Eldon Petty
Producing formation Dry Hole Depth to top Bottom Total Depth of Well 4743 Feet
Show depth and thickness of all water, oil and gas formations.

OIL, GAS OR WATER RECORDS

CASING RECORD

FORMATION	CONTENT	FROM	TO	SIZE	PUT IN	PULLED OUT
				10-3/4"	293'	-0-

Describe in detail the manner in which the well was plugged, indicating where the mud fluid was placed and the method or methods used in introducing it into the hole. If cement or other plugs were used, state the character of same and depth placed, from feet to feet for each plug set.

Filled hole with heavy mud to 290'. Ran HOWCO plug, 1/2 sack hulls, and 25 sacks of cement. Filled with heavy mud to 35'. Ran HOWCO plug, 1/2 sack hulls, and filled to bottom of cellar with 15 sacks cement.

(If additional description is necessary, use BACK of this sheet)

Name of Plugging Contractor Anschutz Drilling Company
Address 709-10 Union National Bank Building, Wichita, Kansas

STATE OF Kansas, COUNTY OF Rice, ss.
W. H. Duley (employee of owner) of the above-described well, being first duly sworn on oath, says: That I have knowledge of the facts, statements, and matters herein contained and the log of the above-described well as filed and that the same are true and correct. So help me God.

(Signature) W. H. Duley
Box 544, Chase, Kansas (Address)

SUBSCRIBED AND SWORN TO before me this 12th day of April, 1955
My commission expires April 14, 1956



W. H. Duley Notary Public.
RECEIVED
STATE CORPORATION COMMISSION

APR 13 1955
04-13-1955
CONSERVATION DIVISION
Wichita, Kansas

PLUGGING
FILE SEC 28 T 9 R 29W
BOOK PAGE 110 LINE 9

15-179-20095-00-00

WELL NO. 1 LEASE Hickory COMPANY Gulf Oil Corporation A.F.E. 204 (8)
 DATE—DRILLING BEGAN 3-20-55 WELL COMPLETED 4-7-55 FIRST PRODUCTION Dry Hole
 SAND RECORD Dry Hole - Well Plugged TOTAL DEPTH 4713
 INITIAL PRODUCTION Oil: —
 Water: —
 Gas: —

CASING RECORD

S— 28 T— 98 R— 294

SIZE	WEIGHT	THD	CLASS	MAKE	SET AT DEPTH	SACKS CEMENT	LBS GAL CHLO	PULLED	LEFT IN
10-3/4	*	*	*	*	236	284			3%
* 2 Jts. 339, 02, A, 65									
5 Jts. 290, - , A, 59									
1 Jt. 316, 02, A, 63									

				Center
				51
				52
				57
			0	

Distance H - 13' from KB to top of 10-3/4" collar.
 TUB 2850

ELEVATION— 2856'

FORMATION RECORDED

	From	To
Surface Mud	0	110
Sand		230
Shale		1390
Sandy Shale		1750
Sand		1850
Shale & Shells		1930
Lime & Shale		2002
2005 Shale & Red Bed		2165
Anhydrite		2195
Shale & Shells		2665
Lime & Shale		2750
Shale & Lime		2930
Lime & Shale		3160
Shale & Lime		3315
Lime & Shale		3377
Lime & Black Chert		3385
Lime & Shale		3400
Shale & Lime		3518
Lime & Shale		3961
Lime		4035
Lime & Shale		4125
Lime		4165
Lime & Shale		4352
Lime		4360
Lime & Shale		4510
Mississippi Lime		4577
Lime		4606
Chert & Lime		4616
Lime		4703
Viols		4710
Arbuckle		4713
Rotary Total Depth		4713

PLUGGING
 FILE SEC 28 T 9 R 29 W
 BOOK PAGE 110 LINE 9

05-04-1955
 DIVISION

