


WELL PLUGGING RECORD

Give All Information Completely
Make Required Affidavit
Mail or Deliver Report to:
Conservation Division
State Corporation Commission
800 Bitting Building
Wichita, Kansas

Thomas

County, Sec. 19 Twp. 9 Rge. (E) 32 (W)

Location as "NE/CNW/SW" or footage from lines NE NE SW
Lease Owner Trans-Tex Drilling Co.
Lease Name Keller Well No. 1
Office Address Box 2347 Longview, Texas
Character of Well (completed as Oil, Gas or Dry Hole) Oil
Date well completed October 9, 1952 19
Application for plugging filed February 22, 1954 19
Application for plugging approved February 24, 1954 19
Plugging commenced 3-3-54 19
Plugging completed 3-10 1954

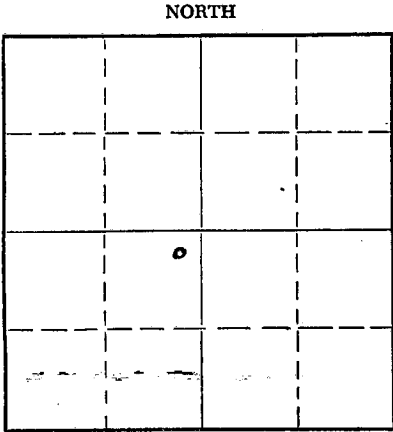

Locate well correctly on above Section Plat

Reason for abandonment of well or producing formation became uneconomical to operate this well as it's production fell to one barrel daily.

If a producing well is abandoned, date of last production June 20, 1953 19

Was permission obtained from the Conservation Division or its agents before plugging was commenced? Yes

Name of Conservation Agent who supervised plugging of this well Eldon Petty Hays, Kansas
Producing formation Mississippi Depth to top 4651 Bottom 4700 Total Depth of Well 5100 Feet
Show depth and thickness of all water, oil and gas formations.

OIL, GAS OR WATER RECORDS

CASING RECORD

FORMATION	CONTENT	FROM	TO	SIZE	PUT IN	PULLED OUT
Mississippi	Lime	4651	4700	9-5/8	303	
Conglomerate - water	Lime	4632	4650	5 1/2"	4751	1599.02
Arbuckle - Dry	Lime	4997	5100	2 1/2"	4722	4722

Describe in detail the manner in which the well was plugged, indicating where the mud fluid was placed and the method or methods used in introducing it into the hole. If cement or other plugs were used, state the character of same and depth placed, from _____ feet to _____ feet for each plug set.

Filled hole with sand from 4724' to 4650'
Dumped 4 sks cement from 4650' to 4618'
After pulling 5 1/2" pipe. Filled hole with mud to 235'. Put in 10' rock bridge to 225' run 15 sks cement from 225' to 180'. Filled hole with mud from 180 to 35' put in 5' rock bridge from 35' to 30' mixed and run 10 sks cement from 30' to top of surface casing.

(If additional description is necessary, use BACK of this sheet)


Name of Plugging Contractor Jayhawk Casing Pulling company
Address Russell, Kansas

STATE OF Kansas, COUNTY OF Russell, ss.
H D Arnett (employee of owner) or (owner or operator) of the above-described well, being first duly sworn on oath, says: That I have knowledge of the facts, statements, and matters herein contained and the log of the above-described well as filed and that the same are true and correct. So help me God.

(Signature) H D Arnett

SUBSCRIBED AND SWORN TO before me this 17th day of March, 1954
Wayne Messweather (Address) 172 W 3rd Haisington Mans

My commission expires _____

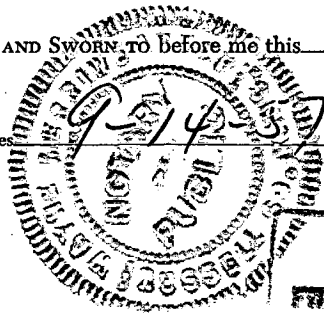

24-7368-S 3-53-20M

RECEIVED
STATE CORPORATION COMMISSION

PLUGGING
FILE SEC 19 T 9 R 32W
BOOK PAGE 15 LINE 12

MAR 25 1954
03-25-1954
CONSERVATION DIVISION
Wichita, Kansas