

STATE OF KANSAS
STATE CORPORATION COMMISSION

WELL PLUGGING RECORD

FORMATION PLUGGING RECORD


Strike out upper line when reporting plugging off formations.

Give All Information Completely
Make Required Affidavit
Mail or Deliver Report to:
Conservation Division
State Corporation Commission,
800 Bittling Building,
Wichita, Kansas

Sedgwick County. Sec. 32 Twp. 28 Rge. 2 (E) (XXX)

Location as "NE 1/4 NW 1/4 SW 1/4" or footage from lines SW SW NE
Lease Owner: The Dickey Oil Company
Lease Name: Schweitzer Well No.
Office Address: The Dickey Oil Company, Ellis-Singleton Bldg., Wichita, Ks.
Character of Well (Completed as Oil, Gas or Dry Hole)
Date, well completed: March 24 1939
Application for plugging filed: March 25 1939
Application for plugging approved: March 24 1939
Plugging Commenced: March 27 1939
Plugging Completed: March 30 1939
Reason for abandonment of well or producing formation: Dry

NORTH

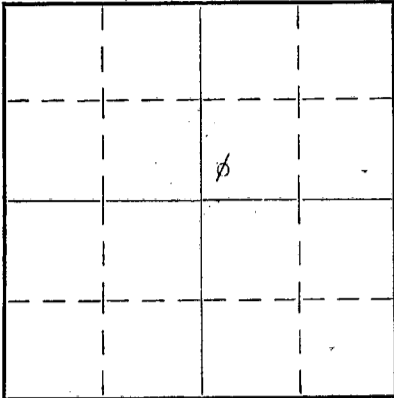

Locate well correctly on above Section Plat

If a producing well is abandoned, date of last production: no production 193
Was permission obtained from the Conservation Division or its agents before plugging was commenced? Yes

Name of Conservation Agent who supervised plugging of this well: Mr. F. D. Carter
Producing formation: Depth to top: Bottom: Total Depth of Well: 2604 Feet
Show depth and thickness of all water, oil and gas formations.

OIL, GAS OR WATER RECORDS

CASING RECORD

Formation	Content	From	To	Size	Put In	Pulled Out
Stalnaker	show gas	2200	2227	7" O.D.	2206	1908

Describe in detail the manner in which the well was plugged, indicating where the mud fluid was placed and the method or methods used in introducing it into the hole. If cement or other plugs were used, state the character of same and depth placed, from... feet to... feet for each plug set.

Filled with heavy mud from 2604 up to 2310; run wood plug and cemented up to 2200; Ripped pipe and pulled up four joints and filled with heavy mud; pulled pipe and filled with heavy mud to 100' and run wood plug and cemented with 20 sacks cement; pulled surface pipe and filled to bottom of cellar and put cement cap in bottom of cellar.

PLUGGING
FILE SEC 32 26 2E
BOOK PAGE 55 LINE 42



(If additional description is necessary use BACK of this sheet)

Correspondence regarding this well should be addressed to: The Dickey Oil Company
Address: Ellis Singleton Building, Wichita, Kansas

STATE OF Kansas, COUNTY OF Sedgwick, ss.

Norris Tickel (employee of owner) or (owner or operator) of the above-described well, being first duly sworn on oath, says: That I have knowledge of the facts, statements, and matters herein contained and the log of the above-described well as filed and that the same are true and correct. So help me God.

(Signature) Norris Tickel
c/o The Dickey Oil Company, Wichita, Kansas
(Address)

SUBSCRIBED AND SWORN TO before me this 3rd day of April, 1939

My commission expires August 2, 1939

Notary Public

THE DICKEY OIL COMPANY
SCHWEITZER No. 1

COMMENCED: December 17, 1938
COMPLETED: February 10, 1939

LOCATION: SW/4 SW/4 NE/4 32-28-2E
Sedgwick County, Kansas
ELEVATION: 1303 feet.

cellar	10	blue shale	1025
clay	33	lime	1030
lime	40	blue slate	1050
clay	45	blue shale	1100
gray shale	60	lime	1105
lime	65	lime & sand	1125
gray shale	75	blue shale	1195
blue shale & gypsum	85	hard lime	1215
blue shale	115	lime	1230
lime	123	blue shale	1235
blue shale	140	lime	1240
lime	160	blue shale	1265
shale & shells	175	lime	1285
brown shale	185	blue shale	1310
blue shale	240	lime	1320
blue slate	250	shale	1345
shale & lime shells	270	blue shale	1365
lime	285	shale	1403
gray shale	295	lime	1430
red rock	320	shale	1460
lime	370	soft lime	1472
blue shale	373	hard lime	1477
lime	420	shale	1482
gray shale	445	soft lime	1525
lime	470	shale	1535
blue shale	475	lime	1595
lime	480	shale	1625
red rock	485	lime	1645
lime	520	shale	1650
blue shale	525	lime	1695
red rock	530	shale	1730
lime	570	lime	1735
red rock	580	shale	1780
lime	595	lime	1810
blue shale	600	shale	1835
lime	610	lime	1890
red rock	615	shale	1900
lime	625	lime	1940
blue shale	635	shale	1970
lime	665	lime	1995
lime & shale	675	shale	2000
lime	695	sandy shale	2040
blue shale	710	shale	2070
lime	730	sandy shale	2085
gray slate	735	shale	2200
lime	760	lime	2206
blue shale	770	sand	2213
lime	805	lime	2215
blue shale	812	sand	2227 1/2
lime	885	lime	2300
blue shale	895	shale	2541
lime	900	Top K. C. Lime	2541
light shale	930	lime	2570
blue slate	965	sand	2575
blue shale	975	lime	2604 TD
lime	980		
blue shale	990		
lime	1000		

PIPE RECORD:

15 1/2" 50'
12 1/2" 1010'
8 " 1340
did not shut off water
lowered to 1411
7 " 1974' 7"
underreamed to 2206' 6"

