


STATE OF KANSAS
STATE CORPORATION COMMISSION

Give All Information Completely
Make Required Affidavit
Mail or Deliver Report to:
Conservation Division
State Corporation Commission
800 Bittling Building
Wichita, Kansas

WELL PLUGGING RECORD

NORTH

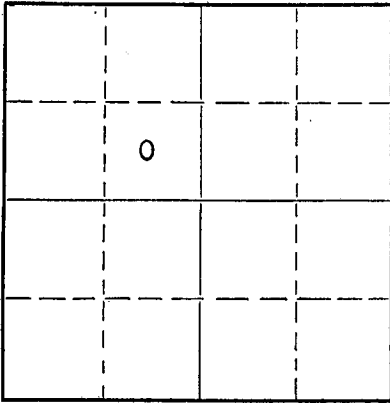

Locate well correctly on above
Section Plat

S Sedgwick County. Sec. 32 Twp. 28 Rge. 2E (E) (W)
Location as "NE/CNW $\frac{1}{4}$ /SW $\frac{1}{4}$ " or footage from lines C SE NW
Lease Owner S. P. Gaty Beech Aircraft Corporation
Lease Name Downs Well No. 21 *veg Dec*
Office Address 11 Cypress Drive, Forrest Hills, Wichita, Kansas
Character of Well (completed as Oil, Gas or Dry Hole) _____
Date well completed _____ 19____
Application for plugging filed March 3, 1950 (verbal) 19____
Application for plugging approved March 6, 1950 19____
Plugging commenced 3/4/50 19____
Plugging completed 3/7/50 19____
Reason for abandonment of well or producing formation _____
If a producing well is abandoned, date of last production _____ 19____
Was permission obtained from the Conservation Division or its agents before plugging was commenced? Yes

Name of Conservation Agent who supervised plugging of this well _____
Producing formation _____ Depth to top _____ Bottom _____ Total Depth of Well 2230 Feet
Show depth and thickness of all water, oil and gas formations.

OIL, GAS OR WATER RECORDS

CASING RECORD

Formation	Content	From	To	Size	Put In	Pulled Out
				12 $\frac{1}{2}$ "		71'4"
				5 $\frac{1}{2}$ "		1998'

Describe in detail the manner in which the well was plugged, indicating where the mud fluid was placed and the method or methods used in introducing it into the hole. If cement or other plugs were used, state the character of same and depth placed, from _____ feet to _____ feet for each plug set.

Rocked hole to 2208 and run 3 sacks of cement.
Mudded hole to 140'. Set 15' rock bridge and run 15 sacks of cement.
Mudded hole to top and run 5 sacks of cement.
Well completed.

4-12-50
APR 12 1950

(If additional description is necessary, use BACK of this sheet)

Correspondence regarding this well should be addressed to S. P. Gaty
Address 11 Cypress Drive
Forrest Hills
Wichita, Kansas
STATE OF Kansas, COUNTY OF Sedgwick, ss.


_____, (employee of owner) or (owner or operator) of the above-described well, being first duly sworn on oath, says: That I have knowledge of the facts, statements, and matters herein contained and the log of the above-described well as filed and that the same are true and correct. So help me God.

(Signature) May Howell
210 N. Edgman Dr. (Address)

SUBSCRIBED AND SWORN to before me this 10th day of April, 19 50
Berence Kooken
Notary Public.

My commission expires January 12, 1952

22-7877-8 4-49-10M

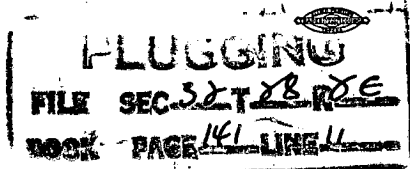

Location - GEN SE NW Sec. 32-28-2E
 Farm - Downs
 County - Sedgwick
 State - Kansas
 Contractor - Beech Aircraft Corporation

Commenced - December 1, 1943
 Completed - January 5, 1944
 Elevation

Subsoil	45	Lime	1165
Sand & Gravel (hole full of water)	55	Shale	1175
Shale (Set 12 1/2" Casing, at 75)	75	Lime	1180
Shale and Shells	90	Shale	1185
Red Rock	100	Lime	1195
Lime	110	Shale	1230
Shale	120	Lime & Shells	1230
Lime & Shells	140	Shale	1235
Lime	155	Lime	1240
Shale & Shells	165	Shale & Lime Shell	1245
Lime	185	Shale	1270
Shale	190	Lime	1280
Lime	200	Shale	1300
Shale	210	Lime	1325
Lime	220	Shale	1335
Shale	245	Lime	1338
Lime	255	Shale	1345
Shale	260	Slate & Lime	1350
Lime	265	Lime	1358
Shale	275	Shale	1480
Lime	290	Shale	1415
Shale	300	Lime	1420
Lime	320	Shale (Water)	1445
Shale	325	Lime	1465
Red Rock	335	Shale	1475
Lime	385	Lime	1495
Shale	400	Shale	1548
Lime	450	Lime	1553
Lime	510	Shale	1558
Red Rock	525	Lime	1590
Lime	545	Shale	1640
Red Rock	550	Lime	1645
Lime	570	Shale	1650
Shale	575	Lime	1695
Lime (Five Bailers of Water)	595	Shale	1705
Red Rock	603	Lime	1710
Lime	620	Shale	1753
Shale	625	Lime	1830
Shale	640	Shale	1860
Lime	650	Shale & Lime Shells	1870
Shale	680	Lime	1885
Lime	685	Lime	1910
Lime	695	Shale (7" O.D. 1915')	1918
Shale	710	Lime	1960
Lime	725	Shale (Water Broken in)	1975
Shale	730	Lime & Shells	1975
Lime	745	Shale	1990
Water Sand	755	Lime	1995
Shale (10" Casing, 760)	760	Slate	2015
Shale	775	Sand	2025
Lime	780	Sandy Lime & Shells	2035
Shale	835	Shale	2035
Lime	840	Shale	2065
Shale	845	Sandy Shale, (Hole full Water)	2125
Lime	865	Shale	2145
Shale	870	Sandy Shale (Lime & Shells)	2165
Lime	885	Sandy Shale	2193
Shale	900	Blue Shale	2201
Lime	920	Shale (5 3/16 Casing at 2208)	2208
Shale	940	Lime	2211
Shale	970		
Sand (wet Hole)	1010		
Shale (Set 8" Casing, 1040)	1040		
Lime	1067		
Shale	1160		

Top of Lansing 2208; Gas 2217-20
 Shot 2217-20 1/2 with 5 qts, no increase.
 Water 2228-30, Gauged quarter million
 ft. of gas.
 Plugged back from 2230 1/2 to 2225.

PLUGGING
 FILE SEC 32-28-2E
 BOOK PAGE 141 LINE 4