

WELL PLUGGING RECORD

FORMATION PLUGGING RECORD


STATE OF KANSAS
CORPORATION COMMISSION

Give All Information Completely
Make Required Affidavit
Mail or Deliver Report to:
Conservation Division
State Corporation Commission
800 Bitting Building
Wichita, Kansas

OR

Strike out upper line
when reporting plug-
ging off formations.

NORTH

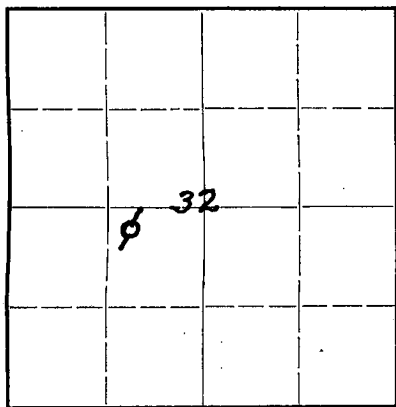

Locate well correctly on above
Section Plat

Sedgwick County. Sec 32 Twp. 28 S Rge 2 (E) (W)
Location as "NE 1/4 NW 1/4 SW 1/4" or footage from lines N 1/2 of SW 1/4 of Sec 32
Lease Owner. Beech Aircraft
Lease Name. Shackley Well No. 1
Office Address. B.F.D.H. Wichita Kansas
Character of Well (completed as Oil, Gas or Dry Hole) Gas
Date well completed. Nov. 1 1943 19 43
Application for plugging filed. OCT 18 19 45
Application for plugging approved. OCT 18 19 45
Plugging commenced. OCT 18 19 45
Plugging completed. OCT 21 19 45
Reason for abandonment of well or producing formation Dry hole

If a producing well is abandoned, date of last production 19
Was permission obtained from the Conservation Division or its agents before plugging was com-
menced? Yes

Name of Conservation Agent who supervised plugging of this well Lily
Producing formation Depth to top. 222' Bottom 222 3/4 Total Depth of Well 2228 Feet
Show depth and thickness of all water, oil and gas formations.



OIL, GAS OR WATER RECORDS

CASING RECORD

Formation	Content	From	To	Size	Put In	Pulled Out
Sand	Water	55	62	12 1/2	59'	59'
Sand	Water	740	750	10"	753'	753'
Sand	Water	1130	1140	8 1/4"	1465'	1465'
Sandy lime	Water	1825	1840	6 5/8"	1870'	1870'
Sandy lime	Water	1880	1890	5 1/2"	2216'	2216'

Describe in detail the manner in which the well was plugged, indicating where the mud fluid was placed and the method or methods used in introducing it into the hold. If cement or other plugs were used, state the character of same and depth placed, from feet to feet for each plug set.

OCT 18 DUMPT 5 SX CEMENT WITH BAILER AT 2228 FILLING HOLE
TO 2195
OCT 20 MUDDED HOLE FROM 2195 TO 150' SET ROCK BRIDGE
AND 15 SX CEMENT
OCT 21 MUDDED HOLE TO 10' RUN 15 SX CEMENT

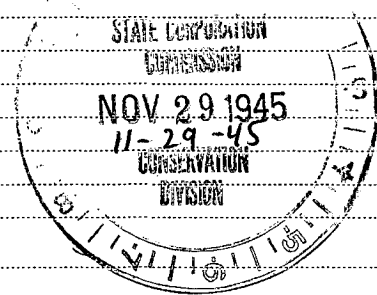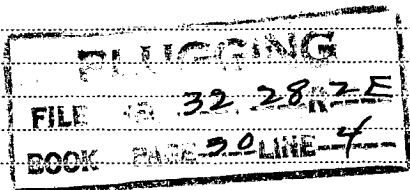

(If additional description is necessary, use BACK of this sheet)

Correspondence regarding this well should be addressed to W. G. Tatbot
Address 601 Petroleum Bldg. Wichita Kansas

STATE OF Kansas COUNTY OF Sedgwick ss.
Max Howell (employee of owner) or (owner or operator) of the above-described well,
being first duly sworn on oath, says: That I have knowledge of the facts, statements, and matters herein contained and the log of the above-described well as filed and that the same are true and correct. So help me God.



(Signature) Max Howell
220 S. Pine Crest (Address)
November 20th day of November, 1945
Jane E. Macaulay Notary Public.
My commission expires December 22, 1947

COMPANY: Beech Aircraft Corporation
 FARM: Shockey No. 1

Sec. 32 T. 28 R. 2E
 NWc NE SW
 Sedgwick County, Kansas

Total Depth: 2228'
 Comm: 9-24-43 Comp. 11-1-43
 Shot or treated:
 Contractor: B. V. Cox

Elevation: 1318
 Production: 250,000G.

Casing
 12 1/2" 59' 6 5/8" 1925'
 10" 753' 5 3/16" 2215'
 8 1/4" 1465'

Figures Indicate Bottom of Formation

surface	8	lime	830	shale	1980
clay	45	shale	840	shale	1990
clay	55	lime	865	lime	2000
sand 1/2"	62	shale	870	shale	2020
shale	75	lime	880	lime	2030
lime	85	shale	890	shale	2065
slate & lime	95	lime	895	sand	2075
lime	110	shale	900	10 BWPB 2065	
shale shells	120	lime	905	sand	2100
lime	130	shale	910	HFV 2080-2090	
shale shells	145	lime	925	sdv shale	2125
lime	160	shale	965	sdv shale	2135
shale	165	lime	975	hole caving	
lime	175	shale	1010	sandy	2145
slate	180	lime	1015	hole still caving	
lime	185	shale	1025	HFV	
slate	195	lime	1037	sdv shale	2150
lime	200	shale	1042	sdv shale, limey	2175
shale	210	lime	1050	sand, limey	2181
lime	215	shale	1125	sand limey	2196
shale	220	lime	1130	sandy	2201
lime	225	sdv lime	1140	shale	2215
shale	235	4 BWPB 1130-40		lime	2216
shale & lime shells	285	shale	1220	lime hard	2218
lime	305	lime	1235	lime	2220
slate	310	shale	1240	sand (gas)	2223 1/2
shale	345	lime	1245	sand water	2228
lime	385	shale	1265		
shale	390	lime	1275	Total Depth	
lime	495	shale	1285	Top Lansing	2215
shale	505	lime	1305		
red rock	515	shale	1325		
lime	535	lime	1330		
shale	545	shale	1340		
lime	565	lime	1345		
shale	575	slate	1360		
lime	585	shale	1365		
lime	595	lime	1425		
red rock	605	shale	1430		
lime	615	lime	1450		
shale	635	shale	1455		
lime	650	lime	1460		
1/2 BW 580-590		shale	1465		
shale	655	shale	1470		
lime	660	lime	1550		
shale	680	lime	1600		
red rock	685	shale	1640		
lime	695	lime	1700		
shale	715	shale	1730		
lime	725	lime	1742		
shale	730	lime	1757		
lime & sand	750	lime	1825		
HFV 740-750		lime sdv	1840		
shale	765	lime white	1860		
shale	775	HFV 1825-40			
lime	780	lime	1880		
shale	785	sdv lime	1890		
lime	790	lime	1912		
shale	815	HFV 1880-90			
lime	820	slate	1919		
shale	825	lime	1925		
		lime	1965		

FILE 32 28 2E
 BOOK 30 11 4

