


STATE OF KANSAS
STATE CORPORATION COMMISSION
CONSERVATION DIVISION
P. O. BOX 17027
WICHITA, KANSAS 67217

FORM CP-4

WELL PLUGGING RECORD

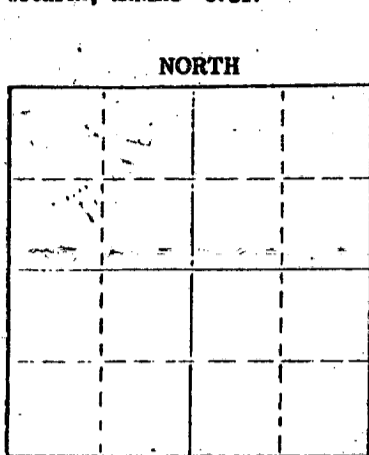

Locate well correctly on above Section Plat

Sedgwick County, Sec 30 Twp 28 Rge 2 (E) x (W)
Location as "NE/CNW/SW" or footage from lines NE SE NE
Lease Owner John J. Darrah Jr.
Lease Name Scott Well No. #2
Office Address 1010 Century Plaza Bldg. Wichita, Kansas
Character of Well (completed as Oil, Gas or Dry Hole)
Date well completed 19
Application for plugging filed 19
Application for plugging approved 19
Plugging commenced 3-25-75 19
Plugging completed 3-31-75 19
Reason for abandonment of well or producing formation

If a producing well is abandoned, date of last production 19
Was permission obtained from the Conservation Division or its agents before plugging was commenced?

Name of Conservation Agent who supervised plugging of this well Ted E. Dewey
Producing formation Depth to top Bottom Total Depth of Well 2267'
Show depth and thickness of all water, oil and gas formations.

OIL, GAS OR WATER RECORDS

CASING RECORD

FORMATION	CONTENT	FROM	TO	SIZE	PUT IN	PULLED OUT
				7"	2237'	1838.63'
				10 3/4"	114'	

Describe in detail the manner in which the well was plugged, indicating where the mud fluid was placed and the method or methods used in introducing it into the hole. If cement or other plugs were used, state the character of same and depth placed, from feet to feet for each plug set.

Pump 25 sacks cement to 1945'.
Bailed down to 220' - set 20' rock bridge. Filled with 6 yards ready-mix concrete.

(If additional description is necessary, use BACK of this sheet)
Name of Plugging Contractor Southwest Casing Pulling Co.
Address Box 364 Great Bend, Kansas

STATE OF Kansas COUNTY OF Barton ss.
Southwest Casing Pulling Co. (employee of owner) or (owner or operator) of the above-described well, being first duly sworn on oath, says: That I have knowledge of the facts, statements, and matters herein contained and the log of the above-described well as filed and that the same are true and correct. So help me God.

(Signature)
Box 364 Great Bend, Kansas (Address)

Subscribed and sworn to before me this 31 day of March, 1975



Sidney D. Miller
Notary Public

RECEIVED
STATE CORPORATION COMMISSION
APR 3 1975
4-3-75
CONSERVATION DIVISION
Wichita, Kansas


WELL LOG BUREAU—KANSAS GEOLOGICAL SOCIETY
 508 East Murdock, Wichita, Kansas

Company- BEECH AIRCRAFT CORP.
 Farm- Scott No. 2

SEC. 30 T. 28 R. 2E
 NE SE NE

Total Depth. 2267'
 Comm. 10-3-56 Comp. 11-30-56
 Shot or Treated.
 Contractor.
 Issued. 12-15-56

County Sedgwick
 KANSAS

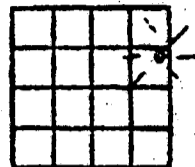

CASING:
 10" 114'
 7" 2237'

Elevation. 1364' KB

Production. Gas Storage Well.

Figures indicate Bottom of Formations.

shale-lime	2102
sand-wtr	2111
shale	2232
brwn lime	2236½ RTD
caving shale	2243
brown lime	2245
shale	2246
sand-Gas est. @ 0,5 M.	2267
Total Depth	
TOPS:Scout	
Lansing	2220

RECEIVED
 STATE CORPORATION COMMISSION

FEB 19 1975

CONSERVATION DIVISION
 Wichita, Kansas