

STATE OF KANSAS
STATE CORPORATION COMMISSION

Give All Information Completely
Make Required Affidavit
Mail or Deliver Report to:
Conservation Division
State Corporation Commission
800 Bittling Building
Wichita, Kansas

WELL PLUGGING RECORD

Sedgwick County. Sec. _____ Twp. 29 Rge. 28S (E) 2 (W)

Location as "NE/CNW/SW" or footage from lines SW/4 NW/4 NW/4

Lease Owner Beech Aircraft Corp.

Lease Name Kennedy Well No. 1

Office Address Wichita 1, Kansas

Character of Well (completed as Oil, Gas or Dry Hole) Dry Hole

Date well completed September 20, 19 56

Application for plugging filed September 20, 19 56

Application for plugging approved September 20, 19 56


Plugging commenced September 24, 19 56

Plugging completed September 28, 19 56

Reason for abandonment of well or producing formation _____

If a producing well is abandoned, date of last production _____ 19 _____

Was permission obtained from the Conservation Division or its agents before plugging was commenced? Yes

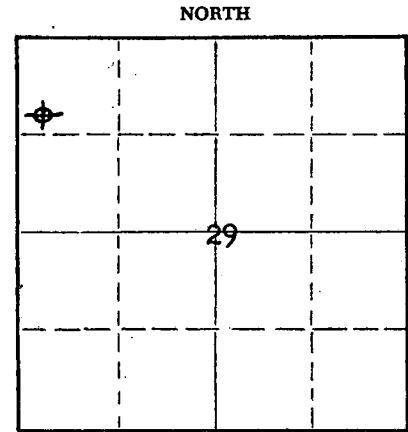

Locate well correctly on above Section Plat

Name of Conservation Agent who supervised plugging of this well Ruel Durkee

Producing formation _____ Depth to top _____ Bottom _____ Total Depth of Well 2281 Feet

Show depth and thickness of all water, oil and gas formations.

OIL, GAS OR WATER RECORDS

CASING RECORD

FORMATION	CONTENT	FROM	TO	SIZE	PUT IN	PULLED OUT

Describe in detail the manner in which the well was plugged, indicating where the mud fluid was placed and the method or methods used in introducing it into the hole. If cement or other plugs were used, state the character of same and depth placed, from _____ feet to _____ feet for each plug set.

Plugged back with sand and 6 sacks cement to 2220'.

Mudded to 165'

Rock bridge w/20 sacks cement at 165'

Mudded to surface

Capped with 5 sacks cement.

RECEIVED
CORPORATION COMMISSION
OCT 9 1956
10-9-56

(If additional description is necessary, use BACK of this sheet)

Name of Plugging Contractor Beech Aircraft Corp.

Address Wichita, Kansas

STATE OF Kansas, COUNTY OF Sedgwick, ss.

Earl Wentworth (employee of owner) or (owner or operator) of the above-described well, being first duly sworn on oath, says: That I have knowledge of the facts, statements, and matters herein contained and the log of the above-described well as filed and that the same are true and correct. So help me God.

(Signature) Earl Wentworth

734 Pippin Court, Wichita, Kansas
(Address)

SUBSCRIBED AND SWORN to before me this 8th day of October, 1956

My commission expires December 12, 1959

J. Arnold Dowd
Notary Public.

PLUGGING
FILE SEC 29 T. 28 R. 3E
BOOK PAGE 102 LINE 7

September-October, 1956

W E L L L O G

KENNEDY #1
SW-NW-NW
Section 29-28S-2E
Elevation - 1369 Kelly bushing
(1362 ground)

Depth

0-1500	Shale and lime
1500 - 1535	Lime
1535 - 1593	Shale
1593 - 1748	Lime and shale
1748 - 1788	Shale
1788 - 2072	Lime and shale
2072 - 2095	Shale
2095 - 2110	Sand
2110 - 2240	Shale
2240 - 2243	Brown lime
2243 - 2266	Sand - tight
2266 - 2282	Brown lime - Total Depth.

PLUGGING
FILE SEC 29 T. 28 R. 2E
BOOK PAGE 102 LINE 7

RECEIVED
STATE CORPORATION COMMISSION

OCT 11 1956

CONSERVATION DIVISION
Wichita, Kansas