

TYPE

AFFIDAVIT OF COMPLETION FORM

ACO-1 WELL HISTORY

SIDE ONE

Two (2) copies of this form shall be filed with the Kansas Corporation Commission, 200 Colorado Derby Building, Wichita, Kansas 67202, within thirty (30) days after the completion of a well, regardless of how the well was completed.

Attach separate letter of request if the information is to be held confidential. If confidential, only file one copy. Information on Side One will be of public record and Side Two will then be held confidential.

Applications must be made on dual completion, commingling, salt water disposal, injection and temporarily abandoned wells.

Attach one copy only wireline logs (i.e. electrical log, sonic log, gamma ray neutron log, etc.). (Rules 82-2-105 & 82-2-125) KCC# (316) 263-3238.

LICENSE # 5768 EXPIRATION DATE 6-30-83

OPERATOR Dean E. Wineland API NO. 15-163-21,761-00-00

ADDRESS Box 247 Natoma, KS 65601 COUNTY Rooks

FIELD

** CONTACT PERSON Dean E. Wineland PHONE 913-885-4701 PROD. FORMATION

PURCHASER n/a LEASE Welling "B"

ADDRESS WELL NO. 1

DRILLING Red Tiger Drilling Company WELL LOCATION NE NW NW

CONTRACTOR 1720 KSB & T Bldg. 330 Ft. from North Line and

ADDRESS Wichita, KS 67202 990 Ft. from West Line of

the NW (Qtr.) SEC 3 TWP 10S RGE 16W.

PLUGGING Allied Cementing Company

CONTRACTOR Box 31, 332 W. Wichita, KS

ADDRESS Russell, KS 67202

TOTAL DEPTH 3295' PBT

SPUD DATE 9-27-82 DATE COMPLETED 10-2-82

ELEV: GR 2054 DF 2056 KB 2059

DRILLED WITH ~~MOBILE~~ (ROTARY) ~~MOBILE~~ TOOLS.


DOCKET NO. OF DISPOSAL OR REPRESSURING WELL BEING USED TO DISPOSE OF WATER FROM THIS LEASE

Amount of surface pipe set and cemented 252' DV Tool Used?

THIS AFFIDAVIT APPLIES TO: (Circle ONE) - Oil, Gas, Shut-in Gas, Dry, Disposal,

Injection, Temporarily Abandoned, OWWO. Other

ALL REQUIREMENTS OF THE STATUTES, RULES AND REGULATIONS PROMULGATED TO REGULATE THE OIL AND GAS INDUSTRY HAVE BEEN FULLY COMPLIED WITH.

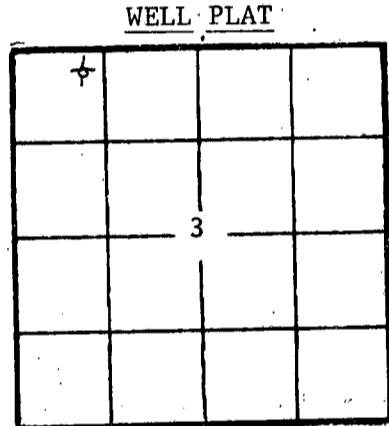

(Office Use Only) KCC [checked] KGS [checked] SWD/REP PLG.

A F F I D A V I T

Dean E. Wineland, being of lawful age, hereby certifies that:

I am the Affiant, and I am familiar with the contents of the foregoing Affidavit. The statements and allegations contained therein are true and correct.

Signature of Dean E. Wineland (Name)

SUBSCRIBED AND SWORN TO BEFORE ME this 7th day of October, 1982.

DELLA M. RICHMOND STATE NOTARY PUBLIC OSBORNE COUNTY, KANSAS My Appt. Exp.

Signature of Della M. Richmond (Notary Public)

MY COMMISSION EXPIRES: 7-12-84

RECEIVED STATE CORPORATION COMMISSION OCT 09 1982 CONSERVATION DIVISION Wichita, Kansas

** The person who can be reached by phone regarding any questions concerning this information.

FILL IN WELL LOG AS REQUIRED:

Show all important zones of porosity and contents thereof; cored intervals, and all drill-stem tests, including depth interval tested, cushion used, time tool open, flowing and shut-in pressures, and recoveries.

SHOW GEOLOGICAL MARKERS LOGS RUN, OR OTHER DESCRIPTIVE INFORMATION.

FORMATION DESCRIPTION, CONTENTS, ETC.	TOP	BOTTOM	NAME	DEPTH
Post Rock	0	40		
Shale & Sand	40	594		
Sand	594	811		
Shale - Sand - Pyrite	811	937		
Shale & Sand	937	1171		
Shale	1171	1234		
Anhydrite	1234	1268		
Red Bed	1268	1480		
Shale	1480	1822		
Shale & Lime St.	1822	2325		
Shale & Lime	2325	2564		
Shale & Lime St.	2564	2980		
Lime	2980	3295		
RTD		3295		

Report of all strings set— surface, intermediate, production, etc. CASING RECORD (New) or (Used)

Purpose of string	Size hole drilled	Size casing set (in O.D.)	Weight lbs/ft.	Setting depth	Type cement	Sacks	Type and percent additives
Surface	12 1/4"	8-5/8"	20#	260'	Common	160 sx	2% Gel., 3% C.C.

LINER RECORD

PERFORATION RECORD

Top, ft.	Bottom, ft.	Sacks cement	Shots per ft.	Size & type	Depth interval

TUBING RECORD

Size	Setting depth	Pecker set at

ACID, FRACTURE, SHOT, CEMENT SQUEEZE RECORD

Amount and kind of material used	Depth interval treated

Date of first production	Producing method (flowing, pumping, gas lift, etc.)	Gravity

RATE OF PRODUCTION PER 24 HOURS	Oil	Gas	Water	Gas-oil ratio
	bbbls.	MCF	%	bbbls.

Disposition of gas (vented, used on lease or sold)	Perforations