


15-179-20420-0000

STATE OF KANSAS
STATE CORPORATION COMMISSION

Give All Information Completely
Make Required Affidavit
Mail or Deliver Report to
Conservation Division
State Corporation Commission
245 North Water
Wichita, KS 67202

FORM CP-4

WELL PLUGGING RECORD

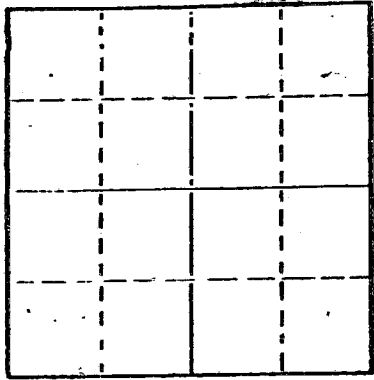

Locate well correctly on above
Section Plat

Sheridan County, Sec 7 Twp 8 Rge 26 (E) (W)
Location as "NE/CNW/SW" or footage from lines NW NE NW
Lease Owner Shields Oil Producers, Inc.
Lease Name Flagler Well No 1
Office Address Shields Bldg., Russell, KS 67665
Character of Well (completed as Oil, Gas or Dry Hole) Dry Hole
Date well completed 8-24 19 76
Application for plugging filed 8-24 19 76
Application for plugging approved 8-24 19 76
Plugging commenced 8-24 19 76
Plugging completed 8-24 19 76
Reason for abandonment of well or producing formation Dry Hole

If a producing well is abandoned, date of last production 19
Was permission obtained from the Conservation Division or its agents before plugging was commenced? yes

Name of Conservation Agent who supervised plugging of this well Gilbert Balthazor, Palco, KS
Producing formation Depth to top Bottom Total Depth of Well 4042 Feet
Show depth and thickness of all water, oil and gas formations.

OIL, GAS OR WATER RECORDS

CASING RECORD

FORMATION	CONTENT	FROM	TO	SIZE	PUT IN	PULLED OUT
Surface pipe				8 5/8"	249'	

Describe in detail the manner in which the well was plugged, indicating where the mud fluid was placed and the method or methods used in introducing it into the hole. If cement or other plugs were used, state the character of same and depth placed, from feet to feet for each plug set.

1st. plug was set @ 1250' with 70 sacks cement RECEIVED
2nd. plug was set @ 250' with 20 sacks cement STATE CORPORATION COMMISSION
3 rd. plug was set @ 40' with 10 sacks cement

SEP 01 1976

CONSERVATION DIVISION
Wichita, Kansas

(If additional description is necessary, use BACK of this sheet)
Name of Plugging Contractor Dreiling Oil, Inc.
Address Rt. #1, Victoria, KS 67671 9-1-76

STATE OF KANSAS COUNTY OF ELLIS
I, Joseph A. Hess, sec.-treas. of Drlg. (employee of owner) or (owner or operator) of the above-described well, being first duly sworn on oath, says: That I have knowledge of the facts, statements, and matters herein contained and the log of the above-described well as filed and that the same are true and correct. So help me God.

(Signature) Joseph A. Hess
JOSEPH A. HESS, HAYS, KS 67601
(Address)

Subscribed and sworn to before me this 30th day of August, 19 76

My commission expires 6-24-78

Diana Presley
Diana Presley Notary Public.

NOTARY PUBLIC KANSAS
ELLIS COUNTY
DIANA PRESLEY
MY COMM. EXP. JUNE 24, 1978

