


WELL PLUGGING RECORD

Give All Information Completely  
Make Required Affidavit  
Mail or Deliver Report to:  
Conservation Division  
State Corporation Commission  
212 No. Market  
Wichita, Kansas

NORTH

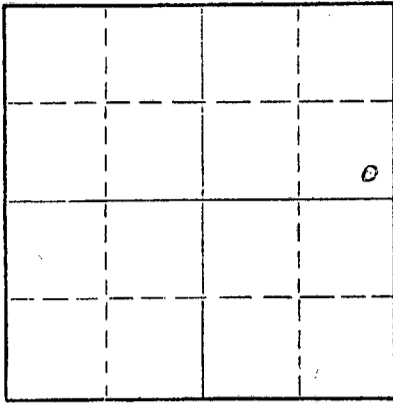

Locate well correctly on above  
Section Plat

Russell County. Sec. 18 Twp. 10S Rge. 23 (X) (W)  
Location as "NE/CNWxSWx" or footage from lines SE SE NE  
Lease Owner Murfin Drilling Company  
Lease Name Gano Well No. 1  
Office Address 617 Union Center, Wichita, Kansas 67202  
Character of Well (completed as Oil, Gas or Dry Hole) Dry Hole  
Date well completed December 16 19 69  
Application for plugging filed " 19 "  
Application for plugging approved " 19 "  
Plugging commenced " 19 "  
Plugging completed " 19 "  
Reason for abandonment of well or producing formation \_\_\_\_\_

If a producing well is abandoned, date of last production \_\_\_\_\_ 19\_\_\_\_  
Was permission obtained from the Conservation Division or its agents before plugging was commenced? Yes

Name of Conservation Agent who supervised plugging of this well W. L. Nichols  
Producing formation \_\_\_\_\_ Depth to top \_\_\_\_\_ Bottom \_\_\_\_\_ Total Depth of Well \_\_\_\_\_ Feet  
Show depth and thickness of all water, oil and gas formations.

OIL, GAS OR WATER RECORDS

CASING RECORD

FORMATION	CONTENT	FROM	TO	SIZE	PUT IN	PULLED OUT
				8 5/8"	215'	

Describe in detail the manner in which the well was plugged, indicating where the mud fluid was placed and the method or methods used in introducing it into the hole. If cement or other plugs were used, state the character of same and depth placed, from \_\_\_\_\_ feet to \_\_\_\_\_ feet for each plug set.

1st Plug @ 1200' with 70 sacks cement  
2nd Plug @ 240' with 25 sacks cement  
3rd Plug @ 40' with 10 sacks cement

RECEIVED  
STATE CORPORATION COMMISSION  
APR 23 1970  
CONSERVATION DIVISION  
Wichita, Kansas

(If additional description is necessary, use BACK of this sheet)

Name of Plugging Contractor Murfin Drilling Company  
Address 617 Union Center, Wichita, Kansas 67202

STATE OF Kansas, COUNTY OF Sedgwick, ss.  
James R. Daniels (employee of owner) or (owner or operator) of the above-described well, being first duly sworn on oath, says: That I have knowledge of the facts, statements, and matters herein contained and the log of the above-described well as filed and that the same are true and correct. So help me God.

(Signature) James R. Daniels  
James R. Daniels  
617 Union Center, Wichita, Kansas  
(Address)



SUBSCRIBED AND SWORN to before me this 22nd day of April 1970  
February 7, 1971  
Wilma V. Brokes  
Notary Public.

15-065-20290-00-00

# WELL LOG

COMPANY Murfin Drilling Company

SEC. 18 T. 10S R. 23W

FARM Gano NO. 1

LOG. SE SE NE


RIG. NO. 16

TOTAL DEPTH 3963'

COUNTRY Graham KANSAS

COMM. 12-9-69

COMP. 12-16-69

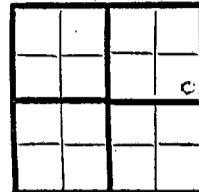

SHOT OR TREATED

CONTRACTOR

Murfin Drilling Company

ISSUED

CASING

20

10

15

8 5/8" @ 215' w/160 sacks

ELEVATION 2403 GL

12

6

2408 KB

13

5

PRODUCTION

FIGURES INDICATE BOTTOM OF FORMATIONS

- 217 Clay, Sand and Shale
- 730 Shale
- 1430 Shale and Shells
- 1980 Shale and Sand
- 2018 Shale
- 2058 Anhydrite
- 2560 Shale and Shells
- 2865 Lime and Shale
- 2985 Lime
- 3105 Lime and Shale
- 3575 Lime
- 3678 Lime and Shale
- 3963 Lime
- 3963 T.D.

RECEIVED  
STATE CORPORATION COMMISSION  
APR 23 1970  
CONSERVATION DIVISION  
Wichita, Kansas

State of Kansas  
County of Sedgwick ss:

I, James R. Daniels of the Murfin Drilling Company

upon oath state that the above and foregoing is a true and correct copy of the log of the Gano #1 well.

James R Daniels  
James R. Daniels  
19 70



Subscribed and sworn to before me this 22nd day of April

My Commission Expires February 7, 1971

Wilma V. Brokes  
Wilma V. Brokes, Notary Public