


15-065-20494-00-00

STATE OF KANSAS
STATE CORPORATION COMMISSION

Form CP-4

Give All Information Completely
Make Required Affidavit
Mail or Deliver Report to:
Conservation Division
State Corporation Commission
212 No. Market
Wichita, Kansas 67202

WELL PLUGGING RECORD

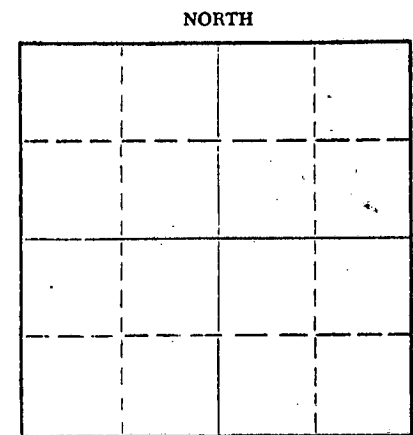

Locate well correctly on above
Section Plat

Graham County. Sec. 26 Twp. 10 Rge. 23W (E) W (W)
Location as "NE/CNWxSWx" or footage from lines 440S-540W From SE of NW
Lease Owner Don E. Pratt Oil Operations
Lease Name Cook Well No. 2
Office Address P. O. Drawer 370 Hays, Kansas 67601
Character of Well (completed as Oil, Gas or Dry Hole) D & A
Date well completed 11-4 1971
Application for plugging filed 11-4 1971
Application for plugging approved 11-4 1971
Plugging commenced 11-4 1971
Plugging completed 11-4 1971
Reason for abandonment of well or producing formation D & A

If a producing well is abandoned, date of last production _____ 19____
Was permission obtained from the Conservation Division or its agents before plugging was commenced? yes

Name of Conservation Agent who supervised plugging of this well Bill Nichols Morland, Kansas
Producing formation _____ Depth to top _____ Bottom _____ Total Depth of Well _____ Feet
Show depth and thickness of all water, oil and gas formations.


OIL, GAS OR WATER RECORDS

CASING RECORD

FORMATION	CONTENT	FROM	TO	SIZE	PUT IN	PULLED OUT
Surface Pipe				8 5/8	155'	

Describe in detail the manner in which the well was plugged, indicating where the mud fluid was placed and the method or methods used in introducing it into the hole. If cement or other plugs were used, state the character of same and depth placed, from _____ feet to _____ feet for each plug set.

1st plug was set @ 925' with 100 cu. ft. cement
2nd plug was set @ 185' with 25 cu. ft. cement
3rd plug was set @ 40' with 10 cu. ft. cement

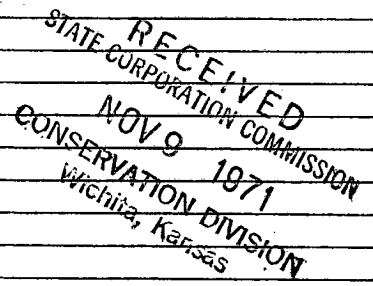

(If additional description is necessary, use BACK of this sheet)


Name of Plugging Contractor Dreiling Oil, Inc.
Address Rt. 2 Victoria, Kansas 67671

STATE OF Kansas COUNTY OF Ellis, ss.
I, Leo F. Dreiling, Pres. of Drilg. Contr. (employer of contractor) of the above-described

well, being first duly sworn on oath, says: That I have knowledge of the facts, statements, and matters herein contained and the log of the above-described well as filed and that the same are true and correct. So help me God.

(Signature) Leo F. Dreiling
LEO F. DREILING, Route 2, Victoria, Kansas 67671
(Address)

Subscribed and Sworn to before me this 8th day of November, 1971

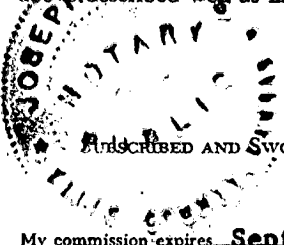

Joseph A. Hess
JOSEPH A. HESS Notary Public.

My commission expires September 19, 1974

DREILING OIL, INC.

Victoria, Kansas 67671

15-065-20494-00-00

DON E PRATT OIL OPERATIONS WELL LOG

Company **Hays, Kansas 67601**
 Farm **Cook No. 2**
 Total Depth **3,808'**
 Comm. **10-27-71** Comp. **11-4-71**
 Contractor **Dreiling Oil, Inc. Victoria, Kansas 67671**

Sec. **26** Twp. **10** Rng. **23W**
440S - 540W
 Location From **SE** of **NW**
 County **Graham**
 Elevation: **2321** **K. B.**
2318 **D. F.**
2316 **G. R.**

Casing Record
155' - 8 5/8"

Cement Record
130 sacks cement

Production:
D & A


Figures Indicate Bottom of Formations

0'	40'	Top Soil & Sand
40'	90'	Shale
90'	155'	Shale
155'	334'	Shale
334'	1356'	Shale
1356'	1542'	Sand
1542'	1550'	Shale & Red Bed
1550'	1840'	Shale & Lime Streaks
1940'	1880'	Anhydrite
1880'	1950'	Shale
1950'	2365'	Shale
2365'	2574'	Shale
2574'	2778'	Shale
2778'	2825'	Lime & Shale Streaks
2825'	2920'	Shale
2920'	3130'	Shale
3130'	3270'	Shale
3270'	3468'	Shale & Lime
3468'	3590'	Shale & Lime
3590'	3642'	Lime
3642'	3668'	Lime
3668'	3695'	Lime
3695'	3770'	Lime
3770'	3780'	Lime
3780'	3808'	Lime
3808'	T.D.	


RECEIVED
STATE CONSERVATION COMMISSION
NOV 9 1971
CONSERVATION DIVISION
Wichita, Kansas

STATE OF KANSAS)
)ss
COUNTY OF ELLIS)

I, Leo F. Dreiling, of Dreiling Oil, Inc. upon states that the above and foregoing is a true and correct copy from the Daily Dreiling Report from the Cook #2.

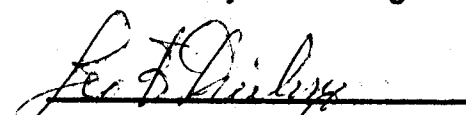
LEO F. DREILING

Subscribed and sworn to before me this 8th day of November, 1971.

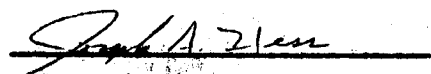
JOSEPH A. HESS, NOTARY PUBLIC

My commission expires: September 19, 1974.

