


STATE OF KANSAS
STATE CORPORATION COMMISSION

WELL PLUGGING RECORD

Give All Information Completely
Make Required Affidavit
Mail or Deliver Report to:
Conservation Division
State Corporation Commission
212 North Market, Insurance Bldg.
Wichita, Kansas

GRAHAM County, Sec. 26 Twp. 10 Rge. 23 (E) W (W)
Location as "NE/CNW%SW%" or footage from lines C SW NW
Lease Owner MORRISON PRODUCING COMPANY
Lease Name COOK Well No. 1
Office Address P.O. BOX 712, ELDORADO, KANSAS
Character of Well (completed as Oil, Gas or Dry Hole) DRY HOLE
Date well completed FEBRUARY 22 1964
Application for plugging filed " 19 64
Application for plugging approved " 19 64
Plugging commenced 9:45 A.M. " 19 64
Plugging completed 12:45 P.M. " 19 64
Reason for abandonment of well or producing formation DRY HOLE

NORTH

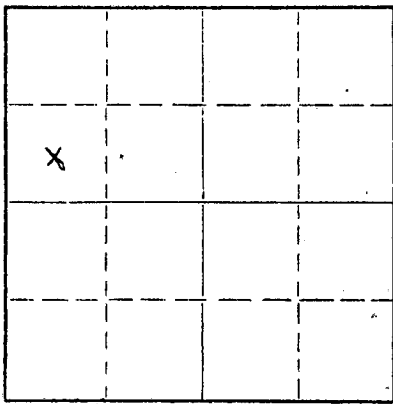

Locate well correctly on above
Section Plat

If a producing well is abandoned, date of last production _____ 19____
Was permission obtained from the Conservation Division or its agents before plugging was com-
menced? YES

Name of Conservation Agent who supervised plugging of this well ELDON PETTY, HAYS, KANSAS
Producing formation _____ Depth to top _____ Bottom _____ Total Depth of Well 3825 Feet
Show depth and thickness of all water, oil and gas formations.

OIL, GAS OR WATER RECORDS

CASING RECORD

FORMATION	CONTENT	FROM	TO	SIZE	PUT IN	PULLED OUT
		0	223	7"	223	--

Describe in detail the manner in which the well was plugged, indicating where the mud fluid was placed and the method or methods used in introducing it into the hole. If cement or other plugs were used, state the character of same and depth placed, from _____ feet to _____ feet for each plug set.

PLUGGED WITH 15 SACKS CEMENT @ 550';
15 SACKS CEMENT @ 210'; 10 SACKS
CEMENT @ 40' TO SURFACE

RECEIVED
STATE CORPORATION COMMISSION

FEB 27 1964

CONSERVATION DIVISION
Wichita, Kansas

(If additional description is necessary, use BACK of this sheet)

Name of Plugging Contractor CHEMICAL & TECHNICAL SERVICES, INC.
Address P.O. BOX D, HILL CITY, KANSAS

STATE OF KANSAS, COUNTY OF GRAHAM, ss.
D. F. MCCARTHY (employee of owner) or (owner) or operator of the above-described well, being first duly sworn on oath, says: That I have knowledge of the facts, statements, and matters herein contained and the log of the above-described well as filed and that the same are true and correct. So help me God.

(Signature) D. F. McCarthy
P.O. BOX D, HILL CITY, KANSAS (Address)

SUBSCRIBED AND SWORN TO before me this 26 day of February, 1964
Donald Low
Notary Public.

My commission expires _____ My commission expires May 25, 1964

CONTRACTOR'S WELL LOG

CONTRACTOR:	CHEMICAL & TECHNICAL SERVICES, INC.
OWNER:	MORRISON PRODUCING COMPANY
WELL:	COOK #1
LOCATION:	C SW NW SEC. 26-10-23 GRAHAM CO., KANSAS
COMMENCED:	2/15/64
COMPLETED:	2/22/64

0	44	CLAY & SAND	ELEVATION: GROUND LEVEL	2297'
44	223	CLAY & BENTONITE	DERRICK FLOOR	2302'
223	710	SHALE & SHELLS	KELLY BUSHING	2304'
710	1332	SHALE & SAND		
1332	1512	SAND		
1512	1581	SAND & SHALE		
1581	1815	SHALE W/LIME STREAKS		
1815	1855	ANHYDRITE		
1855	1925	SHALE W/LIME STREAKS		
1925	2232	SHALE & RED BED		
2232	3548	SHALE & LIME		
3548	3639	LIME		
3639	3686	LIME & SHALE		
3686	3745	LIME		
3745	3825	LIME & SHALE		
3825		ROTARY TOTAL DEPTH		

RECEIVED
STATE CORPORATION COMMISSION

FEB 27 1964

CONSERVATION DIVISION
Wichita, Kansas

SET 7" SURFACE CASING @ 223' W/135 SACKS CEMENT

DRY & ABANDONED

WE HEREBY CERTIFY THIS TO BE A CORRECT AND ACCURATE LOG OF THE ABOVE DESCRIBED WELL,
AS SHOWN ON THE DAILY DRILLING REPORTS.

CHEMICAL & TECHNICAL SERVICES, INC.

BY: *A. F. McCarthy*
ASST. TREASURER

SUBSCRIBED AND SWORN TO BEFORE THIS 26 DAY OF FEBRUARY, 1964.

Donald L. ...
NOTARY PUBLIC

My commission expires May 20, 1964