


15-065-20571-00-00

STATE OF KANSAS  
STATE CORPORATION COMMISSION

Form CP-4

Give All Information Completely  
Make Required Affidavit  
Mail or Deliver Report to:  
Conservation Division  
State Corporation Commission  
P. O. Box 17027  
Wichita, Kansas 67217  
NORTH

WELL PLUGGING RECORD

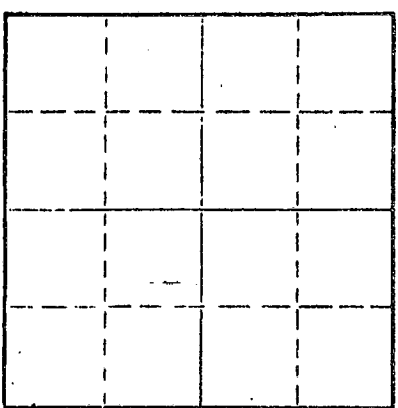

Locate well correctly on above  
Section Plat

Graham County, Sec. 30 Twp. 10 Rge. 23 (E) W (W)  
Location as "NE/CNW4SW4" or footage from lines 440 F. E-440 F. N. of NW/4  
Lease Owner Don E. Pratt Oil Operations  
Lease Name C. Griffith Well No. A-#1  
Office Address P. O. Drawer 370, Hays, Kansas 67601  
Character of Well (completed as Oil, Gas or Dry Hole) Dry Hole  
Date well completed 11-7- 19 72  
Application for plugging filed 11-7 19 72  
Application for plugging approved 11-7 19 72  
Plugging commenced 11-7 19 72  
Plugging completed 11-7 19 72  
Reason for abandonment of well or producing formation Dry Hole

If a producing well is abandoned, date of last production 19  
Was permission obtained from the Conservation Division or its agents before plugging was commenced? yes

Name of Conservation Agent who supervised plugging of this well Bill Nichols Morland, Kansas  
Producing formation \_\_\_\_\_ Depth to top \_\_\_\_\_ Bottom \_\_\_\_\_ Total Depth of Well 3,980 Feet  
Show depth and thickness of all water, oil and gas formations.

OIL, GAS OR WATER RECORDS

CASING RECORD

FORMATION	CONTENT	FROM	TO	SIZE	PUT IN	PULLED OUT
Surface Pipe				8 5/8"	212'	

Describe in detail the manner in which the well was plugged, indicating where the mud fluid was placed and the method or methods used in introducing it into the hole. If cement or other plugs were used, state the character of same and depth placed, from \_\_\_\_\_ feet to \_\_\_\_\_ feet for each plug set.

1st plug was set @ 1,050' w/65 cu. ft. cement  
2nd plug was set @ 215' w/25 cu. ft. cement  
3rd plug was set @ 40 4/10 cu. ft. cement


RECEIVED  
STATE CORPORATION COMMISSION  
NOV 15 1972  
CONSERVATION DIVISION  
Wichita, Kansas

(If additional description is necessary, use BACK of this sheet)  
Name of Plugging Contractor Dreiling Oil, Inc.  
Address Rt. #2, Victoria, Kansas 67671

STATE OF KANSAS, COUNTY OF ELLIS, ss.  
I, Joe Hess, Sec. Treas. of Drlg. Contrc. (superintendent or owner or operator) of the above-described well, being first duly sworn on oath, says: That I have knowledge of the facts, statements, and matters herein contained and the log of the above-described well as filed and that the same are true and correct. So help me God.

(Signature) Joe Hess  
JOE HESS, Rt. #2, Victoria, Kansas 67671  
(Address)

Subscribed and sworn to before me this 14th day of November, 1972  
November 14, 1972

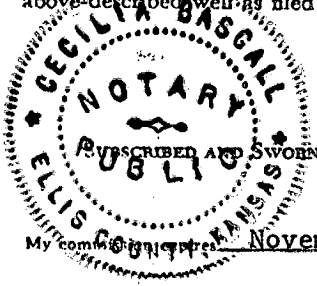

Cecilia Basgall  
CECILIA BASGALL  
Notary Public.

