


WELL PLUGGING RECORD

Give All Information Completely
Make Required Affidavit
Mail or Deliver Report to:
Conservation Division
State Corporation Commission
800 Bitting Building
Wichita, Kansas

NORTH

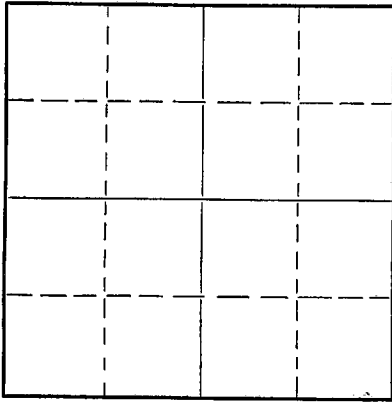

Locate well correctly on above
Section Plat

Sedgwick County, Sec. 26 Twp 28 Rge. 2 (E) ~~XNW~~
Location as "NE/CNW $\frac{1}{4}$ /SW $\frac{1}{4}$ " or footage from lines SE SE SW
Lease Owner Dunne & Strait Drilling Co.
Lease Name Rippe Well No. 1
Office Address 300 Schweiter Bldg., Wichita, Kansas
Character of Well (completed as Oil, Gas or Dry Hole) Dry Hole
Date well completed May 24 19 51
Application for plugging filed May 24 19 51
Application for plugging approved May 24 19 51
Plugging commenced May 24 19 51
Plugging completed May 24 19 51
Reason for abandonment of well or producing formation Dry

If a producing well is abandoned, date of last production 19
Was permission obtained from the Conservation Division or its agents before plugging was commenced? Yes

Name of Conservation Agent who supervised plugging of this well D. C. Lilley, 800 Bitting Bldg., Wichita, Ks
Producing formation Depth to top Bottom Total Depth of Well 3390 Feet
Show depth and thickness of all water, oil and gas formations.

OIL, GAS OR WATER RECORDS

CASING RECORD

Formation	Content	From	To	Size	Put In	Pulled Out

Describe in detail the manner in which the well was plugged, indicating where the mud fluid was placed and the method or methods used in introducing it into the hole. If cement or other plugs were used, state the character of same and depth placed, from feet to feet for each plug set.

Filled with mud to 130'
Set wood plug - 15 sacks cement
Mud to Surface
3 sacks cement - Cap.

RECEIVED
STATE CORPORATION COMMISSION
JUN 5 1951
CONSERVATION DIVISION
Wichita, Kansas

(If additional description is necessary, use BACK of this sheet)

Correspondence regarding this well should be addressed to Dunne & Strait Drilling Company
Address 300 Schweiter Building, Wichita, Kansas

STATE OF Kansas, COUNTY OF Sedgwick, ss.
Almeda Fasnacht (employee of owner) or owner or operator of the above-described well,
being first duly sworn on oath, says: That I have knowledge of the facts, statements, and matters herein contained and the log of the above-described well as filed and that the same are true and correct. So help me God.

(Signature) Almeda Fasnacht
300 Schweiter Bldg., Wichita, Kansas
(Address)

SUBSCRIBED AND SWORN to before me this 4th day of June 19 51

My commission expires October 4, 1953

W. Tankley Notary Public.



PLUGGING
FILE SEC. 24, 28, R. 26
BOOK PAGE 84

WELL LOG

Lease Owner: Dunne & Strait
 Lease: Rippe
 Well No. 1

Location: SE SE SW
 Section: 26-28-2E
 County: Sedgwick

Commenced: May 8, 1951
 Completed: May 24, 1951
 Casing: 8-5/8" - 90'

0 -	90'	Surface
90 -	285	Shale, Shells
285 -	410	Lime, Shale
410 -	560	Shale, Shells
560 -	691	Lime, Shale
691 -	1195	Shale, Shells
1195 -	1470	Shale
1470 -	1595	Sandy Shale, Lime
1595 -	1674	Shale, Lime
1674 -	2006	Lime, Shale
2006 -	2070	Sand, Shale
2070 -	2150	Shale, Lime
2150 -	2155	Shale
2155 -	2218	Lime (Lansing)
2218 -	2325	Lime
2325 -	2420	Lime, Shale
2420 -	2515	Shale
2515 -	2595	Lime (Kansas City)
2595 -	2645	Lime (Top of K.C. 2516)
2645 -	2710	Lime, Shale
2710 -	2750	Lime
2750 -	2803	Lime, Shale
2803 -	3025	Lime, Shale
3080 -	3133	Lime
3133 -	3205	Lime Chert
3205 -	3235	Lime (Miss.)
3235 -	3265	Lime
3265 -	3306	Shale
3306 -	3315	Sand (Top of Simpson 3306)
3315 -	3337	Sand (Simpson)
3360 -	3375	Arbuckle (Top 3364)
3375 -	3390	Arbuckle
-	3390	Total Depth

PLUGGING
 FILE SEC. Net R R 2E
 BOOK PAGE 89 LINE 19