15-173-00006-00-00

STATE OF KANSAS
STATE CORPORATION COMMISSION

Give All Information Completely
Make Required Affidavit
Mail or Deliver Report to:
Conservation Division
State Corporation Commission
800 Bitting Building
Wichita, Kansas

WELL PLUGGING RECORD

Sedgwick County. Sec. 23 Twp. 28 Rge. 2 (E) (W)

Location as "NE/CNW¼SW¼" or footage from lines 330'N 330'W of Center

Lease Owner CITIES SERVICE OIL COMPANY

Lease Name Moynihan Well No. #1

Office Address Bartlesville, Oklahoma

Character of Well (completed as Oil, Gas or Dry Hole) Dry Hole

Date well completed 5-7- 19 53

Application for plugging filed 5-11- 19 53

Application for plugging approved 19

Plugging commenced 5-7- 19 53


Plugging completed 5-7- 19 53

Reason for abandonment of well or producing formation Dry Hole

If a producing well is abandoned, date of last production Dry Hole 19

Was permission obtained from the Conservation Division or its agents before plugging was commenced? yes

NORTH

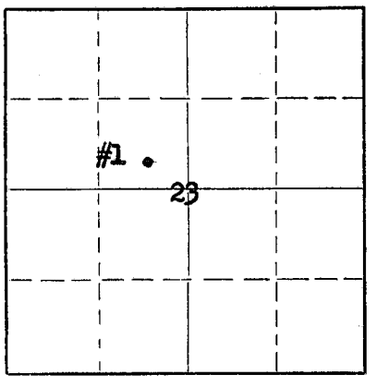

Locate well correctly on above Section Plat

Name of Conservation Agent who supervised plugging of this well Mr. Eurkee

Producing formation Arbuckle Depth to top 3343 Bottom 3361 Total Depth of Well 3361 Feet

Show depth and thickness of all water, oil and gas formations.

OIL, GAS OR WATER RECORDS — CASING RECORD

FORMATION	CONTENT	FROM	TO	SIZE	PUT IN	PULLED OUT

Describe in detail the manner in which the well was plugged, indicating where the mud fluid was placed and the method or methods used in introducing it into the hole. If cement or other plugs were used, state the character of same and depth placed, from feet to feet for each plug set.

Mud to 120', bridge plug to 118', rock to 112' and cemented with 15 sacks cement to 64', mud to 16', rock to 12' and cemented with 8 sacks cement, filled to surface.

RECEIVED
STATE CORPORATION COMMISSION
JUN 4 1953
6-4-53
CONSERVATION DIVISION
Wichita, Kansas

(If additional description is necessary, use BACK of this sheet)

Name of Plugging Contractor Brack Oil Company, Inc.

Address Wichita, Kansas

STATE OF Kansas, COUNTY OF Butler, ss.

C. D. Bradbury (employee of owner) or (owner or operator) of the above-described well, being first duly sworn on oath, says: That I have knowledge of the facts, statements, and matters herein contained and the log of the above-described well as filed and that the same are true and correct. So help me God.

(Signature) C D Bradbury

(Address)

SUBSCRIBED AND SWORN TO before me this 3rd day of June, 1953

Notary Public.

My commission expires June 6, 1955

24-2675-S 2-52—20M

PLUGGING
FILE SEC 23 T 28 R 2E
BOOK PAGE 100 LINE 20

BEN F. BRACK OIL COMPANY, INC.
309-10 BROWN BUILDING
WICHITA 2, KANSAS

MOYNIHAM #1 — SE SE NW — Sec. 23-28S-2E
Total Depth: 3361' — Sedgwick County, Kansas
Commenced: 4-19-53
Completed: 5-7-53

WELL LOG

Shale & Sand	0 -	95'
Shale & Lime		125
Sand & Lime		215
Lime & Shale		610
Shale & Shells		830
Sandy Shale & Shells		1180
Shale, Lime, & Shells		1250
Shale & Lime		1983
Shale & Sand		2042
Shale & Lime		2160
Lime & Shale		2192
Shale & Lime		2206
Lime & Shale		2300
Shale		2415
Shale & Lime		2517
Lime		2595
Lime (Broken)		2655
Lime & Shale		2725
Shale & Sand		2773
Shale & Lime		2963
Lime & Shale		2986
Chert & Shale		3025
Lime & Chert		3090
Lime		3255
Lime & Sand		3280
Sand		3288
Sand & Lime		3295
Sand & Shale		3335
Shale & Lime		3361 T.D.

D & A

The above depths denote bottom of formations.

RECEIVED
STATE CORPORATION COMMISSION
MAY 11 1953
CONSERVATION DIVISION

CASING

8 5/8" — 125'

To the best of my knowledge, the above is a true and correct statement of the depths and formations and where found.

BEN F. BRACK OIL COMPANY, INC.

By Leland C. Brack

WITNESSED:
Gertrude Crist

May 8, 1953.

PLUGGING
FILE SEC 28 T 28 R 2E
BOOK PAGE 100 LINE 20