


STATE OF KANSAS  
STATE CORPORATION COMMISSION

Form CP-4

Give All Information Completely  
Make Required Affidavit  
Mail or Deliver Report to:  
Conservation Division  
State Corporation Commission  
212 No. Market  
Wichita, Kansas

WELL PLUGGING RECORD

NORTH

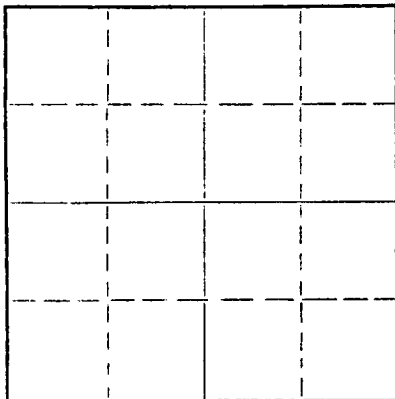

Locate well correctly on above  
Section Plat

Sedgwick County. Sec. 16 Twp. 28 Rge. 2 (E) E (W)  
Location as "NE/CNW/SW" or footage from lines C E/2 NE/4 SE/4  
Lease Owner Tom-Kat, Inc.  
Lease Name Gehring Well No. 1  
Office Address Wichita, Kansas  
Character of Well (completed as Oil, Gas or Dry Hole) \_\_\_\_\_  
Date well completed \_\_\_\_\_ 19\_\_\_\_  
Application for plugging filed \_\_\_\_\_ 19\_\_\_\_  
Application for plugging approved \_\_\_\_\_ 19\_\_\_\_  
Plugging commenced 8-25-66 \_\_\_\_\_ 19\_\_\_\_  
Plugging completed 8-29-66 \_\_\_\_\_ 19\_\_\_\_  
Reason for abandonment of well or producing formation Depleted.

If a producing well is abandoned, date of last production \_\_\_\_\_ 19\_\_\_\_  
Was permission obtained from the Conservation Division or its agents before plugging was commenced? yes

Name of Conservation Agent who supervised plugging of this well Paul Turpin  
Producing formation \_\_\_\_\_ Depth to top \_\_\_\_\_ Bottom \_\_\_\_\_ Total Depth of Well 3018 Feet  
Show depth and thickness of all water, oil and gas formations.

OIL, GAS OR WATER RECORDS

CASING RECORD

FORMATION	CONTENT	FROM	TO	SIZE	PUT IN	PULLED OUT
				8-5/8"	275'	None
				5-1/2"	2987'	2702'

Describe in detail the manner in which the well was plugged, indicating where the mud fluid was placed and the method or methods used in introducing it into the hole. If cement or other plugs were used, state the character of same and depth placed, from \_\_\_\_\_ feet to \_\_\_\_\_ feet for each plug set.

Checked hole to 3012', sanded hole to 2970' and dumped 5 sacks of cement @ 2970' with dump bailer. Pulled 5 1/2" casing, set rock bridge from 185' to 170' and dumped 20 sacks of cement @ 170'. Mudded hole to 35', set rock bridge to 30' and ran 10 sacks of cement to base of cellar.

RECEIVED  
SEP 14 1966  
9-14-66  
CONSERVATION DIVISION  
Wichita, Kansas

PLUGGING COMPLETE.

(If additional description is necessary, use BACK of this sheet)

Name of Plugging Contractor KNIGHT CASING PULLING COMPANY  
Address CHASE, KANSAS

STATE OF KANSAS, COUNTY OF RICE, ss.  
Noel J. Knight (employee of owner) or ~~(owner)~~ of the above-described

well, being first duly sworn on oath, says: That I have knowledge of the facts, statements, and matters herein contained and the log of the above-described well as filed and that the same are true and correct. So help me God.

(Signature) Noel J. Knight  
Chase, Kansas  
(Address)

SUBSCRIBED AND SWORN TO before me this 7th day of September, 1966

My commission expires May 20, 1968 Milton J. Volin Notary Public.

WELL LOG - Gehring #1

SP

OPERATOR: Mr. J. P. Gaty  
c/o Beech Aircraft Corp.  
Wichita, Kansas

LOCATION: C E/2 NE SE  
Section 16-28S-2E  
Sedgwick County, Kansas

CONTRACTOR: Morrison Drilling Company, Inc.  
P. O. Drawer 712  
El Dorado, Kansas

PRODUCTION: \_\_\_\_\_

Farm: Gehring Well No. 1

Date Commenced: May 6, 1952  
Date Completed: May 12, 1952

RTPV.  
1350 KB

Total Depth: 2987 feet - Rotary

<u>From</u>	<u>To</u>	<u>Formation</u>
33	85	Plug and Cement
85	105	Shale
105	200	Lime
200	290	Lime & Shale
290	340	Shale
340	420	Shale w/lime strks.
420	590	Sandy Lime w/shale brks
590	950	Shale & Shells
950	1000	Shale
1000	1150	Shale w/lime brks.
1150	1230	Lime & Shale
1230	1320	Shale w/lime strks.
1320	1375	Shale - sandy
1375	1420	Shale & Shells
1420	1450	Lime & Shale
1450	1540	Shale & Shells
1540	1600	Shale
1600	1685	Lime & Shale strks.
1685	1800	Shale
1800	1886	Lime & Shale
1886	1970	Lime & Shale brks.
1990	2100	Shale
2100	2354	Lime & Shale
2354	2370	Shale & Lime brks.
2370	2517	Shale
2517	2585	Lime
2585	2663	Lime & Shale
2663	2721	Lime
2721	2887	Lime w/shale strks.
2887	2941	Shale & Lime
2941	2967	Shale - Vari. colored
2967	2985	Lime & Chert - Miss.
2985	2987	Lime
2987		Total Depth.

RECEIVED  
 MORRISON DRILLING COMPANY, INC.  
 AMR-R 1952  
 GEORGETOWN DIVISION  
 WICHITA, KANSAS

3017  
1350  
-1667

**Cable Tool Log:**  
 2987' - 2995' Lime  
 2995' - 3000' Lime  
 3000' - 3008' Lime & Chert  
 3008' - 3013' Lime & Dolomit  
 3013' - 3017' Lime - Oil  
 3017' - 3019' Lime T. D.

I hereby certify that the foregoing is a true and correct copy of the Well Log for the #1 Gehring well drilled for Mr. J. P. Gaty and completed May 12, 1952.

MORRISON DRILLING COMPANY, INC.

*C. W. Wilson*  
 \_\_\_\_\_  
 C. W. Wilson - Secretary-Treasurer

STATE OF KANSAS            )  
   ) ss.  
 COUNTY OF BUTLER        )

SUBSCRIBED AND SWORN TO, Before the Undersigned, a Notary Public, in and for the County and State aforesaid this 19th day of May, 1952.



*Am. B. Baker*  
 \_\_\_\_\_  
 Notary Public

My Commission Expires January 10, 1955.