


STATE OF KANSAS  
STATE CORPORATION COMMISSION

Form CP-4

Give All Information Completely  
Make Required Affidavit  
Mail or Deliver Report to:  
Conservation Division  
State Corporation Commission  
212 No. Market  
Wichita, Kansas

WELL PLUGGING RECORD

NORTH

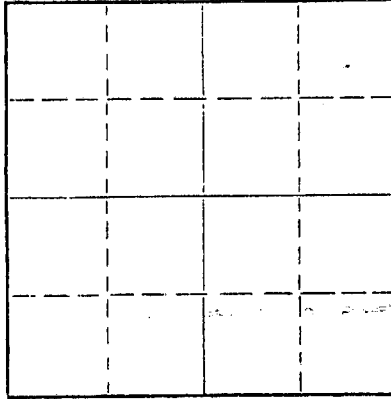

Locate well correctly on above  
Section Plat

Sedgwick County, Sec. 16 Twp. 28 Rge. 2 (E) E (W)  
Location as "NE/CNW/SW" or footage from lines SE SW NE  
Lease Owner Tom- Kat, Inc.  
Lease Name Rick Well No. 1  
Office Address Wichita, Kansas  
Character of Well (completed as Oil, Gas or Dry Hole)  
Date well completed 19  
Application for plugging filed 19  
Application for plugging approved 19  
Plugging commenced 8-19-66 19  
Plugging completed 8-25-66 19  
Reason for abandonment of well or producing formation Depleted.

If a producing well is abandoned, date of last production 19  
Was permission obtained from the Conservation Division or its agents before plugging was commenced? yes

Name of Conservation Agent who supervised plugging of this well Paul Turpin  
Producing formation Depth to top Bottom Total Depth of Well 3280 Feet  
Show depth and thickness of all water, oil and gas formations.

OIL, GAS OR WATER RECORDS

CASING RECORD

FORMATION	CONTENT	FROM	TO	SIZE	PUT IN	PULLED OUT
				13-3/8"	205'	None
				5-1/2"	2951'	2890'

Describe in detail the manner in which the well was plugged, indicating where the mud fluid was placed and the method or methods used in introducing it into the hole. If cement or other plugs were used, state the character of same and depth placed, from feet to feet for each plug set.

Checked hole to 3960', pushed plug to 2945', sanded to 2935' and dumped 5 sacks of cement with dump bailer. Pulled 5 1/2" casing, set rock bridge from 190' to 170' and dumped 5 sacks of cement. Ran 5 joints of 5 1/2" casing in hole and 6 yards of ready mix cement through 5 1/2" casing. Pulled 5 1/2" casing out, set 10' rock bridge @ 35' and capped well with 15 sacks of cement.

RECEIVED  
STATE CORPORATION COMMISSION  
SEP 14 1966  
9-14-66  
CONSERVATION DIVISION  
WICHITA, KANSAS

PLUGGING COMPLETE.

(If additional description is necessary, use BACK of this sheet)

Name of Plugging Contractor KNIGHT CASING PULLING COMPANY  
Address CHASE, KANSAS

STATE OF KANSAS, COUNTY OF RICE, ss.  
Noel J. Knight (employee of owner) or (owner or operator) of the above-described well, being first duly sworn on oath, says: That I have knowledge of the facts, statements, and matters herein contained and the log of the above-described well as filed and that the same are true and correct. So help me God.

(Signature) Noel J. Knight  
Chase, Kansas  
(Address)

SUBSCRIBED AND SWORN TO before me this 2nd day of September, 1966

My commission expires May 20, 1968

Milton J. Volin  
Notary Public.

DRILLING LOG

9

Company: John P. Gaty  
 Rig: Rick #1  
 Commenced: 9-15-51  
 Completed:  
 Contractor: Max Howell

SE/4 SW/4 NE/4, Section 16,  
 Twp. 28S, R. 2E, Sedgwick Co., K.  
 Cable Tools  
 Elevation 1341'  
 Total Depth - 3276'

Casing Record:  
 13 3/8" - 105'  
 10 3/4" - 840'  
 6" - 2105'  
 7" - 2615'  
 5 1/2" - 2951'

Water Record:  
 60 - 65 Holo Full  
 440 - 445 1 Bailer  
 710 - 720 Holo Full  
 1420 - 1425 1 Bailer  
 1550 - 1560 3/4 Bailer  
 1638 - 1643 1/4 Bailer  
 1825 - 1835 2 Bailer  
 2533 - 2541 5 Bailer  
 2567 - 2575 Holo Full

0-50	Grey Shale	840-860	Lime	1800-1815	Lime	2773-2781	Lime
-60	Shale	-870	Blue Shale	-1835	Lime	-2795	Lime
-65	Lime	-880	Lime	-1855	Lime	-2805	Shale
-75	Shale	-895	Shale & Shells	-1865	Lime	-2808	Lime
-95	Broken Lime	-900	Lime Hard	-1875	Shale	-2820	Lime
-105	Shale	-910	Shale	-1880	Lime	-2827	Shale
-125	Lime	-975	Shale	-1890	Lime	-2830	Shale
-135	Shale	-1005	Shale	-1915	Lime	-2835	Lime
-170	Lime	-1025	Lime	-1945	Lime	-2857	Shale
-180	Blue Shale	-1050	Lime	-1950	Shale	-2867	Lime
-185	Lime	-1060	Shale	-1965	Shale	-2878	Shale
-190	Lime	-1065	Lime	-1970	Lime	-2892	Lime
-200	Shale	-1085	Shale (Soft)	-1977	Lime	-2905	Shale
-215	Lime	-1090	Lime	-2010	Shale	-2912	Shale
-225	Shale	-1100	Shale	-2055	Shale	-2925	Lime
-235	Lime	-1110	Lime	-2065	Sand	-2929	Shale
-240	Shale	-1143	Shale	-2097	Shale Sandy	-2934	Shale V.C.
-245	Lime	-1155	Shale & Shells	-2105	Shale	-2950	V. C.
-275	Lime	-1200	Lime	-2125	Shale	-2951	Lime
-295	Shale	-1205	Blue Shale	-2130	Lime	-2970	Lime
-310	R. Rock	-1215	Lime-White, Hard	-2160	Shale & Shells	-2990	Lime
-315	R. Rock	-1225	Lime - Grey	-2170	Lime	-3005	Lime
-390	Lime	-1230	Shale	-2210	Lime	-3035	Lime
-405	Lime	-1240	Lime	-2215	Shale	-3052	Lime
-415	Shale	-1243	Lime	-2275	Shale	-3058	Lime Hard
-435	Shale & Shells	-1248	Shale	-2295	Lime	-3060	Lime Soft
-470	Lime	-1265	Lime H.D.	-2305	Shale	-3075	Lime
-490	Shale	-1294	Lime	-2315	Lime	-3075	Lime
-500	R. Rock	-1300	White Shale	-2320	Lime	-3125	Lime
-510	Shale	-1302	Shale	-2385	Shale	-3150	Lime
-515	Lime	-1310	Lime	-2390	Shale	-3175	Lime
-525	Shale	-1320	Shale	-2405	Lime	-3177	Lime
-535	Lime	-1322	Shale	-2435	Shale	-3190	Shale
-575	Lime	-1325	Lime	-2480	Shale	-3205	Lime
-580	R. Rock	-1365	Shale	-2482	Lime K.C.	-3215	Lime
-585	Lime	-1375	Shale	-2487	Lime	-3240	Shale
-590	Lime	-1410	Lime	-2490	Shale	-3276	Shale
-620	Shale	-1440	Lime	-2505	Lime	-3280	Sand
-625	Lime Hard	-1445	Shale	-2525	Lime		
-635	Lime	-1450	Lime	-2536	Lime		
-640	Shale	-1465	Lime	-2538	Shale		
-650	Lime	-1500	Shale & Shells	-2540	Lime		
-655	R. Rock	-1515	Lime	-2567	Lime		
-660	Lime	-1520	Shale	-2575	M. Sand		
-675	Shale	-1535	Lime	-2600	Lime		
-690	Shale	-1560	Lime	-2612	Lime		
-710	Lime	-1580	Lime	-2615	Shale		
-720	Sanded Lime	-1600	Blue Shale	-2625	Lime		
-725	Lime	-1610	Lime	-2630	Lime		
-730	Lime	-1625	Lime	-2631	Shale		
-735	Shale	-1630	Shale	-2640	Lime H.D.		
-740	Lime	-1640	Lime	-2650	Lime		
-755	Shale	-1670	Lime H.D.	-2665	Lime		
-765	Blue Shale	-1680	Lime	-2679	Lime		
-770	Lime	-1710	Shale	-2679	Shale		
-780	Lime	-1720	Lime	-2695	Lime		
-795	Shale & Shells	-1730	Lime	-2704	Lime		
-800	Lime	-1735	Shale	-2725	Shale		
-810	Blue Shale	-1745	Lime	-2730	Shale		
-815	Lime	-1753	Shale	-2738	Lime		
-825	Blue Shale	-1755	Lime	-2750	Shale		
-830	Lime	-1775	Lime	-2770	Shale		
-840	Lime	-1800	Lime	-2773	Lime		

-3276 Top Simpson