

WELL PLUGGING RECORD

STATE OF KANSAS STATE CORPORATION COMMISSION


FORMATION PLUGGING RECORD

Give All Information Completely Make Required Affidavit Mail or Deliver Report to: Conservation Division State Corporation Commission 800 Bittling Building Wichita, Kansas

Strike out upper line when reporting plugging of formations.

Sedgwick County. Sec. 8 Twp. 26 Rge. 2 (E) (W) Location as "NE1/4NW1/4SW1/4" or footage from lines SE/4 SW/4 NE/4 Lease Owner J. P. Gaty Lease Name Myers Well No. 2 Office Address 11 Cypress Drive, Wichita, Kansas Character of Well (completed as Oil, Gas or Dry Hole) Dry Hole Date well completed December 24 19 48 Application for plugging filed 19 Application for plugging approved 19 Plugging commenced December 27 19 48 Plugging completed December 30 19 48 Reason for abandonment of well or producing formation Dry Hole

NORTH

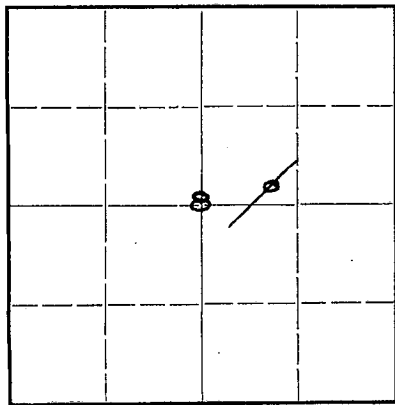

Locate well correctly on above Section Flat

Name of Conservation Agent who supervised plugging of this well Dwight Lilley, Wichita, Kansas Producing formation Burgess Sandstone Depth to top 2978 Bottom 2980 Total Depth of Well 2980 Feet Show depth and thickness of all water, oil and gas formations.

OIL, GAS OR WATER RECORDS

CASING RECORD

Table with 7 columns: Formation, Content, From, To, Size, Put In, Pulled Out. Contains data for casing sizes 12 1/2", 10", 8", and 7" with corresponding depths.

Describe in detail the manner in which the well was plugged, indicating where the mud fluid was placed and the method or methods used in introducing it into the hold. If cement or other plugs were used, state the character of same and depth placed, from feet to feet for each plug set.

Set rock Bridge @ 200' Dumped 15 sacks of cement - mudded Cemented bottom of cellar with rock and 5 sacks of cement

RECEIVED

Conservation Div. 1-26-49 JAN 26 1949

STATE CORPORATION COMMISSION KANSAS

(If additional description is necessary, use BACK of this sheet)

Correspondence regarding this well should be addressed to W. G. Talbott Address 709 Petroleum Building, Wichita 2, Kansas

STATE OF KANSAS COUNTY OF SEDGWICK


Jack Brown, Agent (employee of owner) or (owner or operator) of the above-described well, being first duly sworn on oath, says: That I have knowledge of the facts, statements, and matters herein contained and the log of the above-described well as filed and that the same are true and correct. So help me God.

(Signature) Jack Brown 709 Petroleum Building (Address)

SUBSCRIBED AND SWORN to before me this 25th day of January 19 49

My commission expires October 13, 1952

20-1300-s 11-42-10M

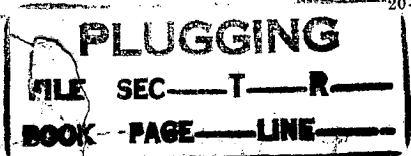

Notary Public.

6

Company: John P. Gaty
Farm: Myers #2

Section 8, T 26, R 2 E
SE SW NE
Sedgwick County, Kansas
Cable Tools
Elevation: 1407' D.F.
Total Depth: 2980'
D & A

Contractor: Max Howell
Comm: November 9, 1948
Comp: December 31, 1948

Casing: 12 1/2" @ 1149'
10 " @ 1577'
8 " @ 2610'
7 " @ 2960'

Cellar	0-6	Shale	945-947
Clay	-15	Lime	-960
Shale	-20	Shale	-995
Shale & Shells	-75	Lime	-1005
Shale	-155	Shale	-1025
Lime	-165	Lime	-1035
Shale	-170	Shale	-1045
Lime	-175	Red rock	-1049
Shale	-195	Lime	-1053
Lime	-210	Shale	-1060
Shale	-215	Lime	-1065
Lime	-250	Red rock	-1075
Shale	-255	Shale	-1095
Lime	-285	Lime	-1100
Shale	-295	Shale	-1110
Lime	-300	Lime	-1115
Shale	-310	Shale	-1135
Shale & Shells	-330	Sandy lime	-1145
Shale	-340	Shale	-1175
Lime	-355	Lime	-1180
Shale & Shells	-365	Shale	-1210
Shale	-385	Lime	-1215
Red rock	-390	Shale	-1220
Lime	-425	Broken lime	-1235
Shale	-430	Shale	-1270
Lime	-485	Lime	-1300
Shale	-515	Shale	-1320
Lime	-525	Lime	-1330
Shale	-530	Shale	-1340
Lime	-540	Lime	-1360
Shale	-545	Shale	-1375
Lime	-565	Lime	-1380
Shale	-570	Shale	-1395
Lime	-595	Lime	-1405
Shale	-605	Shale	-1455
Lime	-625	Lime	-1525
Shale	-630	Shale	-1545
Red rock	-635	Sand	-1585
Lime	-655	Shale	-1585
Shale	-665	Broken lime	-1600
Lime	-675	Lime	-1640
Shale	-685	Shale	-1675
Lime	-700	Lime	-1690
Shale	-705	Shale	-1700
Lime	-715	Lime	-1710
Broken lime	-765	Shale	-1715
Lime	-775	Lime	-1735
Shale	-780	Shale	-1755
Lime	-790	Lime	-1770
Broken lime	-800	Shale	-1780
Lime	-805	Lime	-1795
Shale	-810	Shale	-1810
Lime	-830	Lime	-1835
Shale	-840	Black shale	-1840
Lime shells & shale	-855	Lime	-1895
Lime	-900	Shale	-1905
Shale	-910	Lime	-1945
Broken lime	-925	Black shale	-1950
Lime	-945	Lime	-1955

PLUGGING
FILE SEC 8 T 26 R 2 E
BOOK PAGE 26 LINE 21

RECEIVED
Conservation Div.
JAN 26 1949
STATE CORPORATION
CONTROL DIV.
KANSAS

cont.

Myers #2 - cont.
SE SW NE
Section 8, T 26, R 2 E

Shale & shells	1955-1965
Lime	-1980
Shale	-2005
Lime	-2010
Shale	-2150
Lime	-2160
Shale	-2195
Lime	-2230
Shale	-2300
Lime	-2370
Shale	-2400
Lime	-2415
Shale	-2502
Lime	-2509
Shale	-2517
Lime	-2616
Shale	-2620
Sand	-2625
Lime	-2650
Black shale	-2652
Lime	-2654
Shale, gray	-2660
Lime	-2672
Shale	-2730
Lime	-2745
Shale & shells	-2766
Lime	-2770
Shale Lime shells	-2780
Shale & shells	-2795
Shale	-2805
Lime	-2816
Shale	-2825
Lime shells	-2830
Shale	-2840
Lime shells	-2850
Lime	-2865
Shale	-2870
Shells & shale	-2890
Shale	-2905
Lime	-2915
Shale	-2927
Sand	-2930
Varicolored shale, sandy	-2958-60
Varicolored shale	-2975
Sand	-2980

Total Depth @ 2980'

Tops: Kansas City 2502'
Burgess SS. 2978'

Water Record: 1 BW 20-25
1 $\frac{1}{2}$ BW 870-875
HFW 1545-1555
1 $\frac{1}{2}$ BW 1920-1930
1 BW 2410-2415
1 BW 2808-2810
HFW 2975 -2980

2954 = 2958 Sand line measurement.

RECEIVED

Conservation Div.

JAN 26 1949

STATE COOPERATION
COMMISSION
KANSAS

Myers #2 - cont.
SE SW NE
Section 8, T 26, R 2 E

Shale & shells	1955-1965
Lime	-1980
Shale	-2005
Lime	-2010
Shale	-2150
Lime	-2160
Shale	-2195
Lime	-2230
Shale	-2300
Lime	-2370
Shale	-2400
Lime	-2415
Shale	-2502
Lime	-2509
Shale	-2517
Lime	-2616
Shale	-2620
Sand	-2625
Lime	-2650
Black shale	-2652
Lime	-2654
Shale, gray	-2660
Lime	-2672
Shale	-2730
Lime	-2745
Shale & shells	-2766
Lime	-2770
Shale Lime shells	-2780
Shale & shells	-2795
Shale	-2805
Lime	-2816
Shale	-2825
Lime shells	-2830
Shale	-2840
Lime shells	-2850
Lime	-2865
Shale	-2870
Shells & shale	-2890
Shale	-2905
Lime	-2915
Shale	-2927
Sand	-2930
Varicolored shale, sandy	-2958-60
Varicolored shale	-2975
Sand	-2980

Total Depth @ 2980'

Tops: Kansas City 2502'
Burgess SS. 2978'

Water Record: 1 BW 20-25
1½ BW 870-875
HFW 1565-1555
1 BW 1920-1930
1 BW 2410-2415
1 BW 2808-2810
HFW 2975 -2980

2954 = 2958 Sand line measurement.