

STATE OF KANSAS  
STATE CORPORATION COMMISSION


WELL PLUGGING RECORD

Give All Information Completely  
Make Required Affidavit  
Mail or Deliver Report to:  
Conservation Division  
State Corporation Commission  
800 Bitting Building  
Wichita, Kansas

Butler County, Sec. 1 Twp. 26S Rge. 3 (E) (W)

Location as "NE/CNW 1/4 SW 1/4" or footage from lines SW/4, NE/4, NW/4,  
Lease Owner B. V. Cox, et al.  
Lease Name Edmiston Well No. 5  
Office Address Eldorado, Kansas.  
Character of Well (completed as Oil, Gas or Dry Hole) Dry hole  
Date well completed October 22nd 1951  
Application for plugging filed " 22nd 1951  
Application for plugging approved " 22nd 1951  
Plugging commenced " 23rd 1951  
Plugging completed " 24th 1951  
Reason for abandonment of well or producing formation

NORTH

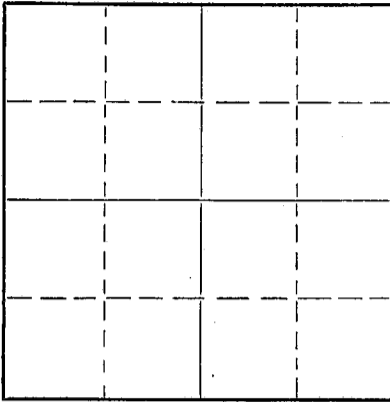

Locate well correctly on above Section Plat

If a producing well is abandoned, date of last production 19  
Was permission obtained from the Conservation Division or its agents before plugging was commenced? yes

Name of Conservation Agent who supervised plugging of this well A. L. Loman  
Producing formation Depth to top Bottom Total Depth of Well 2696 Feet  
Show depth and thickness of all water, oil and gas formations.

OIL, GAS OR WATER RECORDS

CASING RECORD

Formation	Content	From	To	Size	Put In	Pulled Out
Sand	Water	40'	45'	16"	67'	67'
"	"	75'	80'	13"	105'	105'
Lime	"	560'	825'	10 3/4"	910'	910'
"	"	825'	835'	8 5/8"	2320'	2320'
"	"	870'	880'			
"	"	1350'				
"	"	1595'				
"	"	1985'				

Describe in detail the manner in which the well was plugged, indicating where the mud fluid was placed and the method or methods used in introducing it into the hole. If cement or other plugs were used, state the character of same and depth placed, from feet to feet for each plug set.

Lime Oil ~~XXXX~~ 2225' 2230'  
" Water 2275'  
Chat Oil 2682' - 2685'

Three sacks cement on top of 10 ft. mud in bottom - mud to 165 ft. - 15 sacks cement on 15 ft rock bridge - mud to 15 ft. - 5 sacks cement on 10 ft. rock bridge - dirt to surface.

STATE CORPORATION COMMISSION  
NOV - 1 1951

(If additional description is necessary, use BACK of this sheet)  
Correspondence regarding this well should be addressed to B. V. Cox, Conservation Division, Eldorado, Kansas.

STATE OF Kansas, COUNTY OF Butler, ss.  
B. V. Cox (owner or operator) of the above-described well, being first duly sworn on oath, says: That I have knowledge of the facts, statements, and matters herein contained and the log of the above-described well as filed and that the same are true and correct. So help me God.

(Signature) B. V. Cox  
Eldorado, Kansas (Address)

SUBSCRIBED AND SWORN to before me this 31st day of October, 1951  
Notary Public.



PLUGGING  
FILE SEC 1786 R 3e  
BOOK PAGE 10 LINE 34

WELL LOG

Owner - B. V. Cox, et al.

Location:

Farm - Edmiston Well - #5

31/4, NE/4, NW/4,  
Sec 1, Twp 26S, R 3E,  
Butler County, Kansas.

Total depth - 2696'

Casing Record:

Commenced - 9-29-51

16" - 67' Pulled

Completed - 10-23-51

13" - 105' "

Contractor - Cox & Burns

10 3/4" - 910' "

8 5/8" - 2320' "

Production - Dry

Figures indicate bottom of formation

surface soil	10	shale	855	lime	2375
shale	40	lime	860	shale	2445
sand	65	shale	865	lime	2450
HFV 40'-45'		shale & shells	880	shale	2470
lime	50	2 B. 870-80'		lime	2485
shale	67	shale	955	shale	2515
sand	80	lime	980	lime	2540
HFV 75'-80'		shale	985	shale	2550
lime	95	lime	995	lime	2575
red rock	100	shale	1000	shale	2580
shale	110	shale & shells	1040	lime	2595
lime	210	lime	1050	shale	2615
shale	230	shale	1075	lime	2620
shale & shells	250	shale & shells	1150	shale	2640
shale	265	shale	1160	lime	2650
lime	280	lime	1190	shale	2660
shale	285	shale	1200	conglomerate	2675
lime	300	lime	1210	chat	2693
shale	310	shale	1230	show oil	2682-85'
red rock	320	lime	1235	lime	2696
lime	325	shale	1270		
shale	350	lime	1320		
lime	360	shale	1330		
shale	370	lime	1355		
lime	380	1 B. 1350'			
shale & shells	410	shale	1365		
shale	420	lime	1385		
shale & shells	430	shale	1390		
shale	445	lime	1400		
lime	450	shale	1410		
shale	470	lime	1460		
lime	480	shale	1470		
shale	485	shale & shells	1490		
lime	495	lime	1500		
shale	500	shale	1505		
lime	505	lime	1515		
shale	550	shale	1530		
lime	580	lime	1560		
1 B. 560'		shale	1565		
shale	585	lime	1580		
lime	600	shale	1585		
shale	630	lime	1625		
lime	645	1 B. 1595'			
shale	660	shale	1635		
lime	670	lime	1660		
shale	680	shale	1675		
lime	695	lime	1685		
shale & shells	725	shale	1820		
red rock	730	lime	1830		
lime	735	shale	1860		
shale	745	lime	1885		
lime	750	shale	1920		
shale	755	lime	2065		
lime	760	1 B. 1985'			
shale	775	shale	2210		
lime	780	lime	2315		
shale	830	2 B. 2225-30'			
2 B. 825'-35'		3 B. 2275'			
lime	850				

RECEIVED  
MISSION  
NOV - 1 1951  
CONSERVATION DIVISION  
Wichita, Kansas  
**PLUGGING**  
FILE SEC. 1 T. 26R 36  
BOOK PAGE 10 LINE 34