

Give All Information Completely
Make Required Affidavit
Mail or Deliver Report to:
Conservation Division
State Corporation Commission
211 No. Broadway
Wichita, Kansas

WELL PLUGGING RECORD



Sedgwick County, Sec. 30 Twp. 26 Rge. 2 (E) (W)

Location as "NE/CNW&SW¼" or footage from lines SE/4 SE/4 NE/4

Lease Owner John P. Gaty Estate

Lease Name Brown Well No. #2

Office Address 4601 E. Douglas, Suite 204, Wichita, Kansas

Character of Well (completed as Oil, Gas or Dry Hole) Oil

Date well completed December 19 48

Application for plugging filed February 4, 19 64

Application for plugging approved February 5, 19 64


Plugging commenced February 5, 19 64

Plugging completed February 7, 19 64

Reason for abandonment of well or producing formation Depleted

If a producing well is abandoned, date of last production October 19 63

Was permission obtained from the Conservation Division or its agents before plugging was commenced? Yes

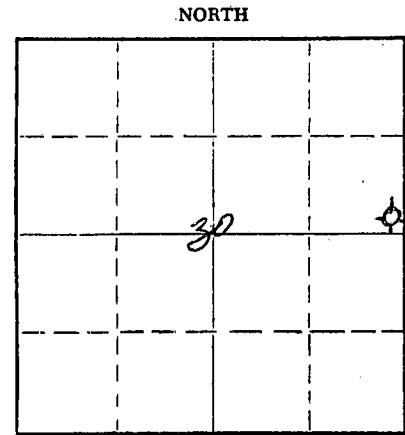

Locate well correctly on above Section Plat

Name of Conservation Agent who supervised plugging of this well Paul Turpin

Producing formation _____ Depth to top _____ Bottom _____ Total Depth of Well 2,951 Feet

Show depth and thickness of all water, oil and gas formations.

OIL, GAS OR WATER RECORDS

CASING RECORD

FORMATION	CONTENT	FROM	TO	SIZE	PUT IN	PULLED OUT

Describe in detail the manner in which the well was plugged, indicating where the mud fluid was placed and the method or methods used in introducing it into the hole. If cement or other plugs were used, state the character of same and depth placed, from _____ feet to _____ feet for each plug set.

Filled hole with rock to 2,590 ft. and added 5 sacks cement.
Mudded to 200 ft.
20 ft. rock bridge with 20 sacks cement at 200 ft.
Mudded to 20 ft.
Rock bridge with 5 sacks cement to surface.

RECEIVED
STATE CORPORATION COMMISSION

FEB 12 1964
2-12-64

CONSERVATION DIVISION
Wichita, Kansas

(If additional description is necessary, use BACK of this sheet)

Name of Plugging Contractor John P. Gaty Estate

Address 4601 E. Douglas - Suite 204, Wichita, Kansas 67218

STATE OF KANSAS COUNTY OF SEDGWICK ss. J. Arnold Dowd

(employee of owner) or (owner or operator) of the above-described well, being first duly sworn on oath, says: That I have knowledge of the facts, statements, and matters herein contained and the log of the above-described well as filed and that the same are true and correct. So help me God.

(Signature) J. Arnold Dowd

(Address)

SUBSCRIBED AND SWORN TO before me this 11th day of February, 19 64

J. A. Crouch

Notary Public.

My commission expires March 8, 1966



9

WELL LOG

John P. Gaty, Owner - Brown No. 2 - Section 30, Township 26, Range 2 East,
SE SE NE, Sedgwick County, Kansas

FIGURES INDICATE BOTTOM OF FORMATION

0 To	8 Cellar	905 to	932 Lime	2200 to	2235 Shale
	20 Clay		970 Shale		2355 Lime
	55 Shale		980 Lime		2365 Shale
	60 Lime		1025 Shale		2395 Lime
	95 Shale		1030 Red Rock		2445 Shale
	110 Lime		1072 Shale		2460 Lime
	155 Shale		1077 Lime		2485 Shale
	190 Lime		1090 Shale		2605 Lime
	200 Shale		1100 Soft Lime		2610 Shale
	220 Lime		1105 Lime		2660 Lime
	235 Shale		1200 Shale		2725 Shale
	250 Lime		1210 Lime		2735 Lime
	260 Shale		1245 Shale		2753 Shale
	270 Lime		1250 Lime		2783 Lime
	290 Shale		1253 Shale		2795 Shale
	295 Red Rock		1285 Lime		2810 Lime
	315 Shale		1300 Shale		2820 Shale
	340 Lime		1335 Lime		2860 Lime
	365 Shale		1340 Shale		2868 Shale
	515 Lime		1345 Lime		2875 Lime
	525 Shale		1405 Shale		2905 Shale
	575 Shale & Shells		1415 Lime		2916 Lime
	580 Shale		1450 Sandy Shale		2935 Shale
	595 Sand		1485 Lime		2937 Sandy Shale, S. O.
	605 Shale		1490 Shale		2951 Steel Tape Measure
	615 Red Rock		1500 Lime		Total Depth 2951
	630 Lime		1535 Shale		
	635 Shale		1570 Sand		
	645 Lime		1625 Lime		
	650 Shale		1655 Shale		
	655 Lime		1670 Lime		
	680 Shale		1720 Shale & Shells		
	695 Lime		1730 Shale		
	705 Shale		1740 Lime		
	710 Lime		1765 Shale		
	725 Shale		1775 Lime		
	735 Lime		1790 Shale		
	740 Shale		1815 Lime		
	755 Lime		1855 Shale		
	770 Shale		1925 Lime		
	795 Lime		1950 Shale		
	810 Shale		1965 Lime		
	830 Lime		2127 Shale		
	840 Shale		2135 Lime		
	895 Lime		2150 Shale		
	905 Shale		2200 Lime		

RECEIVED
STATE CORPORATION COMMISSION

FEB 6 1964

CONSERVATION DIVISION
Wichita, Kansas

Well Log

John P. Gaty - Brown No. 2 - Continued

Spudded - 12/9/48
Completed - 1/8/49

Tools

Kansas City - 2508

Water Record

2½ bailers per hour	- 770	- 780
9 " " "	- 860	
1½ " " "	-1090	-1100
H.F.W.	-1415	-1450
H.F.W.	-1535	-1565
4 bailers per hour	-2280	-2290

Pipe Record

13-3/8"	- 925 Ft.
10"	- 1458 Ft.
8"	- 2580 Ft.
7"	- 2937 Ft.

State of Kansas)
County of Sedgwick) ss

I, C. A. Black, Drilling Contractor of the above-described well, being first duly sworn on oath, declare: That, I have knowledge of the facts, statements and matters herein contained pertaining to the log of the above-described well as filed, and that the same are true and correct.

(Signed) C. A. Black, Partner

Subscribed and Sworn to before me this 26th day of Jan., 1949.

(Signed) Jack F. Theakston

My Commission expires January 22, 1951.

RECEIVED
STATE CORPORATION COMMISSION
FEB 6 1949
CONSERVATION DIVISION
Wichita, Kansas