

STATE OF KANSAS
STATE CORPORATION COMMISSION

WELL PLUGGING RECORD

Give All Information Completely
Make Required Affidavit
Mail or Deliver Report to:
Conservation Division
State Corporation Commission
800 Bitting Building
Wichita, Kansas

Sedgwick County, Sec. 30 Twp 26S Rge. 2 (E) (W)

Location as "NE/CNW%SW%" or footage from lines SE/4 NE/4 NE/4

Lease Owner John P. Gaty

Lease Name Brown Well No. 3

Office Address 11 Cypress drive, Wichita, Kansas

Character of Well (completed as Oil, Gas or Dry Hole) Oil

Date well completed March 23 1949

Application for plugging filed April 28 1955

Application for plugging approved April 29 1955


Plugging commenced May 3 1955

Plugging completed May 7 1955

Reason for abandonment of well or producing formation Water

If a producing well is abandoned, date of last production November 1954

Was permission obtained from the Conservation Division or its agents before plugging was commenced? Yes

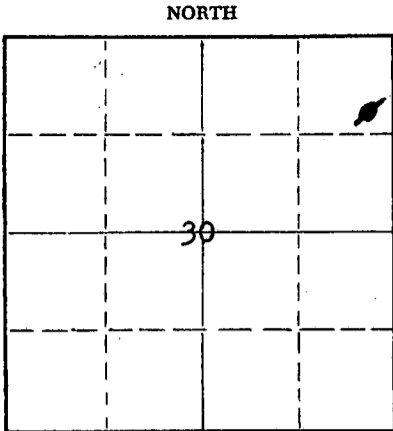

Locate well correctly on above Section Plat

Name of Conservation Agent who supervised plugging of this well Ruel Durkee

Producing formation Burgess Depth to top _____ Bottom _____ Total Depth of Well 2953 Feet

Show depth and thickness of all water, oil and gas formations.

OIL, GAS OR WATER RECORDS

CASING RECORD

FORMATION	CONTENT	FROM	TO	SIZE	PUT IN	PULLED OUT

Describe in detail the manner in which the well was plugged, indicating where the mud fluid was placed and the method or methods used in introducing it into the hole. If cement or other plugs were used, state the character of same and depth placed, from _____ feet to _____ feet for each plug set.

Filled with sand to 2940 Ft.
Six sacks of cement at 2940 ft.
Mudded to 170 Ft.
20 Ft. rock bridge with 20 sacks cement
Mudded to bottom of cellar
5 Sacks cement at bottom of cellar
Filled cellar with mud.

(If additional description is necessary, use BACK of this sheet)

Name of Plugging Contractor John P. Gaty

Address 11 Cypress Dr., Wichita, Kansas

STATE OF Kansas, COUNTY OF Sedgwick, ss. Earl Wentworth (employee of owner) or (owner or operator) of the above-described

well, being first duly sworn on oath, says: That I have knowledge of the facts, statements, and matters herein contained and the log of the above-described well as filed and that the same are true and correct. So help me God.

(Signature) X Earl Wentworth

734 Pippin Court, Wichita, Kansas
(Address)

SUBSCRIBED AND SWORN to before me this 11th day of June 1955

My commission expires December 12, 1955



J. Arnold Sewell
Notary Public.

RECEIVED
STATE CORPORATION COMMISSION

PLUGGING
FILE SEC 30 Twp 26 R 2E
BOOK PAGE 15 LINE 15

MAY 12 1955
5-12-55
CONSERVATION DIVISION
Wichita, Kansas

WELL LOG

John P. Gaty, Owner - Brown No. 3 - Section 30, Township 26, Range 2 East
SE NE NE, Sedgwick County, Kansas

FIGURES INDICATE BOTTOM OF FORMATION

0 to 115 Shale	1070 to 1080 Shale	2205 to 2250 Shale
125 Lime	1105 Lime	2310 Lime
150 Shale	1215 Shale	2330 Shale
195 Lime	1220 Lime	2400 Lime
200 Shale	1225 Shale	2405 Shale
230 Lime	1230 Lime	2420 Lime
240 Shale	1265 Shale	2502 Shale
255 Lime	1310 Lime	2620 Lime
265 Shale	1325 Shale	2625 Black Shale
275 Lime	1340 Lime	2650 Lime
295 Shale	1375 Shale	2653 Black Shale
302 Red Rock	1385 Lime	2675 Lime
365 Shale	1440 Shale	2735 Shale
370 Lime	1450 Sandy Shale	2745 Lime
375 Shale	1455 Lime	2765 Shale
545 Lime	1490 Shale & Shells	2775 Lime
550 Shale	1495 Shale	2795 Shale
560 Lime	1505 Lime	2845 Lime
565 Shale	1510 Shale	2850 Shale
615 Lime	1515 Lime	2860 Lime
620 Red Rock	1580 Shale	2865 Shale
627 Shale	1593 Sandy Shale	2875 Lime
645 Lime	1600 Shale	2890 Shale
655 Shale	1685 Lime	2905 Lime
675 Lime	1690 Shale	2917 Shale
680 Shale	1710 Lime	2930 Lime
765 Lime	1715 Shale	2945 V.C. Shale
775 Shale	1735 Lime	2953 Lime
790 Lime	1785 Shale	2953 Sand
810 Shale	1800 Lime	2953 - Total Depth
830 Lime	1810 Shale	
850 Shale	1835 Lime	
855 Lime	1845 Shale	
875 Shale	1850 Lime	
885 Lime	1880 Shale	
890 Shale	1930 Lime	
900 Lime	1950 Shale	
910 Shale	1965 Lime	
925 Lime	1980 Shale	
935 Shale	1985 Lime	
945 Lime	1995 Shale	
1030 Shale	2000 Lime	
1035 Red Rock	2163 Shale	
1060 Shale	2190 Lime	
1070 Red Rock	2205 Sandy Shale	

RECEIVED
STATE CORPORATION COMMISSION

MAY 12 1955

CONSERVATION DIVISION
Wichita, Kansas

PLUGGING
FILE SEC 30 T 26 R 2E
BOOK PAGE 115 LINE 15

Well Log

-2-

John P. Gaty - Brown No. 3 - Continued

Spudded - 2/15/49
Completed - 3/23/49

Top
Kansas City - 2515

Pipe Record
13-3/8" - 980 Ft.
10" - 1455 Ft.
6-3/8" - 2950 Ft.

Water Record
B ballers per hour - 875
H.F.W. - 1580 - 1595
2 1/2 " " " - 2725

State of Kansas)
County of Sedgwick) ss

I, C. A. Black, Drilling Contractor of the above-described well, being first duly sworn on oath, declare: That, I have knowledge of the facts, statements and matters herein contained pertaining to the log of the above-described well as filed, and that the same are true and correct.

C. A. Black

Subscribed and sworn to before me this 31st day of Mar., 1949.

Jack F. Pheakston

My commission expires January 22, 1951.

