


Give All Information Completely
Make Required Affidavit
Mail or Deliver Report to:
Conservation Division
State Corporation Commission
211 No. Broadway
Wichita, Kansas

15-173-03386-00-00

WELL PLUGGING RECORD

NORTH

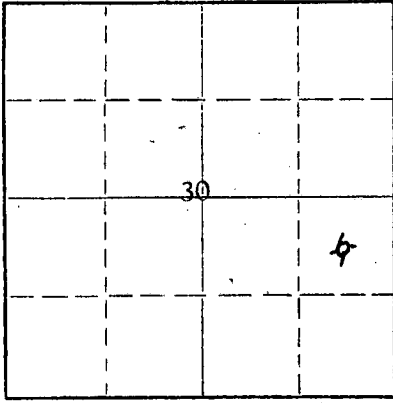

Locate well correctly on above Section Plat

Sedgwick County. Sec. 30 Twp. 26S Rge. 2 (E) 1 (W) SE
Location as "NE/CNW/SW" or footage from lines. 600' SW of Cen of NE NE SE
Lease Owner John P. Gaty
Lease Name Christie Well No. 3
Office Address 11 Cypress Drive
Character of Well (completed as Oil, Gas or Dry Hole) Dry Hole
Date well completed Oct. 4, 19 60
Application for plugging filed Oct. 5, 19 60
Application for plugging approved Oct. 6, 19 60
Plugging commenced Oct. 5 19 60
Plugging completed Oct. 15 19 60
Reason for abandonment of well or producing formation Dry Hole

If a producing well is abandoned, date of last production _____ 19 ____
Was permission obtained from the Conservation Division or its agents before plugging was commenced? Yes

Name of Conservation Agent who supervised plugging of this well Lee N. Guthrie
Producing formation _____ Depth to top _____ Bottom _____ Total Depth of Well 2960 1/2 Feet
Show depth and thickness of all water, oil and gas formations.

OIL, GAS OR WATER RECORDS

CASING RECORD

FORMATION	CONTENT	FROM	TO	SIZE	PUT IN	PULLED OUT

Describe in detail the manner in which the well was plugged, indicating where the mud fluid was placed and the method or methods used in introducing it into the hole. If cement or other plugs were used, state the character of same and depth placed, from _____ feet to _____ feet for each plug set.

Filled with sand 2960 1/2' to 2900'
5 Sacks cement at 2900'
Mudded to 200'
20' rock bridge at 200'
Ready mix cement to surface.

RECEIVED
STATE CORPORATION COMMISSION
11-1-60
NOV 1 1960
CONSERVATION DIVISION
Wichita, Kansas

(If additional description is necessary, use BACK of this sheet)
Name of Plugging Contractor John P. Gaty
Address 11 Cypress Dr., Wichita, Kansas

STATE OF Kansas, COUNTY OF Sedgwick, ss.
Earl Wentworth (employee of owner) or (owner or operator) of the above-described well, being first duly sworn on oath, says: That I have knowledge of the facts, statements, and matters herein contained and the log of the above-described well as filed and that the same are true and correct. So help me God.

(Signature) Earl Wentworth
734 Pippin Court, Wichita 3, Kansas
(Address)

SUBSCRIBED AND SWORN to before me this 31st day of October, 19 60

My commission expires December 12, 1963

J. Arnold Dowd Notary Public.

FORMATION LOG

Christie #3
 SE $\frac{1}{4}$ of Sec. 30-26S-2E
 Sedgwick County, Kansas
 OPERATOR: JOHN P. GATY

Well commenced Sept. 18, 1960
 7" casing cemented @ 2939 ft.
 Sept. 25, 1960.

	Ft.	FT.
Surface soil & clay	0	25
Shale & red bed	25	50
Shale & lime	50	78
Lime	78	95
Lime & shale	95	600
Shale & lime	600	905
Shale & lime strks.	905	1525
Shale & lime	1525	1790
Lime & shale	1790	1925
Shale & lime	1925	2200
Lime & shale	2200	2420
Shale & lime strks.	2420	2523
Shale	2523	2536
K. C. Lime	2536	2661
Shale & lime	2661	2809
Lime & shale	2809	2905
Shale & lime	2905	2939
Burgess Sand	2939	2943
Total Depth	2943	

This is a true and exact copy of formation, taken from The Daily Drilling Reports.

Harold Martin Drilling Company, Inc.

Harold U. Martin, President

STATE OF KANSAS
 COUNTY OF COWLEY

Sworn to before me this 26th day of September, 1960.

My Commission expires October 13, 1962.

Signed:

Dorothy Ellen Martin
 Notary Public

COPY

RECEIVED
 STATE CORPORATION COMMISSION

NOV 1 1960

CONSERVATION DIVISION
 Wichita, Kansas