


STATE OF KANSAS
STATE CORPORATION COMMISSION

WELL PLUGGING RECORD

Give All Information Completely
Make Required Affidavit
Mail or Deliver Report to
Conservation Division
State Corporation Comm.
245 North Water
Wichita, KS 67202

Sedgwick County. Sec. 30 Twp. 26 Rge. 2 E/W XX
Location as "NE/CNW $\frac{1}{2}$ SW $\frac{1}{2}$ " or footage from lines _____
NW SE SE

Lease Owner Raymond Oil Co., Inc.
Lease Name Comotara Well No. 1
Office Address 200 W. Douglas; Suite 800; Wichita, Ks.
Character of Well (Completed as Oil, Gas or Dry Hole) 67202
Dry Hole

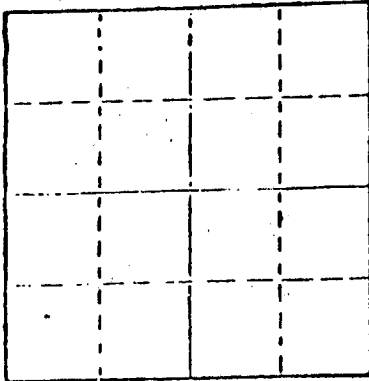

Locate well correctly on above
Section Plat

Date Well completed 5/17 1979
Application for plugging filed 5/17 1979
Application for plugging approved 5/17 1979
Plugging commenced 5/17 1979
Plugging completed 5/17 1979
Reason for abandonment of well or producing formation _____
Dry Hole

If a producing well is abandoned, date of last production _____
19____

Was permission obtained from the Conservation Division or
its agents before plugging was commenced? yes

Name of Conservation Agent who supervised plugging of this well Don Thompson
Producing formation _____ Depth to top _____ Bottom _____ Total Depth of Well _____
Show depth and thickness of all water, oil and gas formations.

OIL, GAS OR WATER RECORDS

CASING RECORD

FORMATION	CONTENT	FROM	TO	SIZE	PUT IN	PULLED OUT
				8 5/8"	210'	

Describe in detail the manner in which the well was plugged, indicating where the mud fluid
was placed and the method or methods used in introducing it into the hold. If cement or other
plugs were used, state the character of same and depth placed, from _____ feet to
_____ feet for each plug set,

- 5/17/79 Mud to 215', plug, plugged with 25 sacks cement.
- 5/17/79 Mud to 40', plug, plugged with 10 sacks cement.
- 5/17/79 Rathole plugged with 3 sacks cement.

RECEIVED
STATE CORPORATION COMMISSION

MAY 24 1979

5-24-79

CONSERVATION DIVISION
Wichita, Kansas

(If additional description is necessary, use BACK of this sheet)

Name of Plugging Contractor White & Ellis Drilling, Inc.
Box 448, El Dorado, Ks. 67042

STATE OF Kansas COUNTY OF Butler, ss.
Ernest Sifford (employee of owner) or (owner or operator)
of the above-described well, being first duly sworn on oath, says: That I have knowledge of
the facts, statements, and matters herein contained and the log of the above-described well
as filed and that the same are true and correct. So help me God.

(Signature)

Ernest Sifford
El Dorado, Kansas

(Address)

SUBSCRIBED AND SWORN TO before me this 21 day of May, 19 79



L. B. AUER

Notary Public.

My commission expires _____

DRILLERS LOG

OPERATOR: Raymond Oil Co., Inc.; 200 W. Douglas; Suite 800; Wichita, Ks.
 CONTRACTOR: White & Ellis Drilling, Inc., Box 448, El Dorado, Kansas 67042 67202

Lease Name Comotara Well No. 1

Sec. 30 T. 26 R. 2E Spot NW SE SE

County Sedgwick State Kansas Elevation _____

Casing Record:

Surface: 8 5/8" @ 210' with 65 Sxs.

Production: _____ @ _____ with _____ Sxs.

Type Well: D & A Total Depth 3097' K.B.

Drilling Commenced: 5/12/79 Drilling Completed 5/17/79

Formation	From	To	Tops
Cellar	0	7	Kansas City - 2515
Lime, Shale	7	2190	Mississippi - 2993
Lime	2190	2400	
Shale, Lime	2400	2515	
Lime	2515	2584	
Lime, Shale	2584	2993	
Lime	2b93	3087	

COMPLETION RECORD

Liner Record: Size _____ From _____ To _____

Cementing Record: _____ Sacks _____

Perforating Record:

Formation	Perforated Interval	Number Shots

RECEIVED
STATE CORPORATION COMMISSION

MAY 24 1979

CONSERVATION DIVISION
Wichita, Kansas

Initial Production: _____

Electric Log _____ Type and Depths Covered _____
