

STATE OF KANSAS
STATE CORPORATION COMMISSION

WELL PLUGGING RECORD

OR
FORMATION PLUGGING RECORD

Strike out upper line
when reporting plug-
ging off formations.

Give All Information Completely
Make Required Affidavit
Mail or Deliver Report to:
Conservation Division
State Corporation Commission
800 Bitting Building
Wichita, Kansas

Sedgwick County. Sec. 31 Twp. 26 Rge. 2 (E) ~~XXX~~

Location as "NE $\frac{1}{4}$ NW $\frac{1}{4}$ SW $\frac{1}{4}$ " or footage from lines. NE SW SW

Lease Owner. Beech Aircraft Corporation

Lease Name. Allen Well No. 1

Office Address. Wichita, Kansas

Character of Well (completed as Oil, Gas or Dry Hole) Dry Hole

Date well completed. August 5, 1946 19

Application for plugging filed. August 20, 1946 19

Application for plugging approved. 19


Plugging commenced. August 21, 1946 19

Plugging completed. August 28, 1946 19

Reason for abandonment of well or producing formation. Dry Hole

If a producing well is abandoned, date of last production. 19

Was permission obtained from the Conservation Division or its agents before plugging was com-
menced? Yes

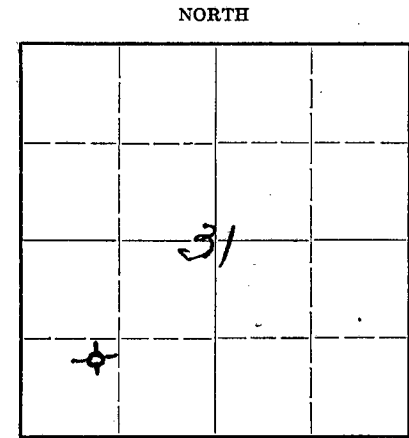

Locate well correctly on above
Section Plat

Name of Conservation Agent who supervised plugging of this well. Dwight Lilly

Producing formation. Depth to top. Bottom. Total Depth of Well 3380 Feet

Show depth and thickness of all water, oil and gas formations.


OIL, GAS OR WATER RECORDS

CASING RECORD

Formation	Content	From	To	Size	Put In	Pulled Out
				12 $\frac{1}{2}$ "	1230	1180
				10 "	1605	1605
				8 "	2618	2618
				7 "	3064	3064
				5 "	3324	3324

Describe in detail the manner in which the well was plugged, indicating where the mud fluid was placed and the method or methods used in introducing it into the hole. If cement or other plugs were used, state the character of same and depth placed, from _____ feet to _____ feet for each plug set.

H ole filled to 3180 with mud. Filled with mud to 2618, set bridge at 220',
Run 20 sax cement and filled to surface with mud. 5' cement plug at bottom of cellar.

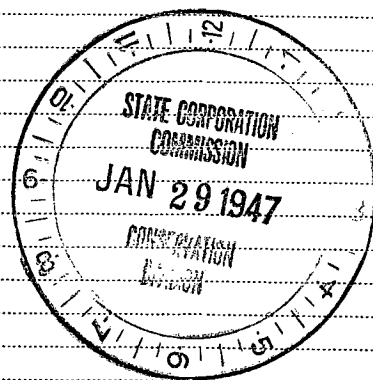


PLUGGING
FILE 31 26 R 2 E
BOOK PAGE 68 LINE 19

(If additional description is necessary, use BACK of this sheet)

Correspondence regarding this well should be addressed to. Beech Aircraft Corporation
Address. Wichita, Kansas

STATE OF Kansas, COUNTY OF Sedgwick, ss.
Fred Murphy (contractor) or (owner or operator) of the above-described well,
being first duly sworn, on oath, says That I have knowledge of the facts, statements, and matters herein contained and the log of the above-
described well as filed and that the same are true and correct. So help me God.

(Signature) Fred Murphy
Wichita, Kans (Address)

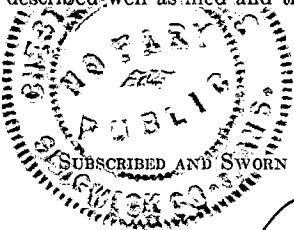

SUBSCRIBED AND SWORN to before me this 18th day of January, 1947

My commission expires Aug 19 1950 Charles Williams Notary Public.