

STATE OF KANSAS  
STATE CORPORATION COMMISSION

WELL PLUGGING RECORD

OR  
FORMATION PLUGGING RECORD

Strike out upper line when reporting plugging off formations.

Give All Information Completely  
Make Required Affidavit  
Mail or Deliver Report to:  
Conservation Division  
State Corporation Commission  
800 Bittling Building  
Wichita, Kansas

Sedgwick County, Sec. 31 Twp. 26 Rge. 2 (E) XXX

Location as "NE $\frac{1}{4}$ NW $\frac{1}{4}$ SW $\frac{1}{4}$ " or footage from lines NW NE NW

Lease Owner **Beech Aircraft Corporation**

Lease Name **Crabb** Well No. **1**

Office Address **Wichita, Kansas**

Character of Well (completed as Oil, Gas or Dry Hole) **Dry Hole**

Date well completed **December 5, 1946** 19

Application for plugging filed **December 5, 1946** 19

Application for plugging approved 19


Plugging commenced **December 6, 1946** 19

Plugging completed **December 9, 1946** 19

Reason for abandonment of well or producing formation **Dry Hole**

If a producing well is abandoned, date of last production 19

Was permission obtained from the Conservation Division or its agents before plugging was commenced? **Yes**

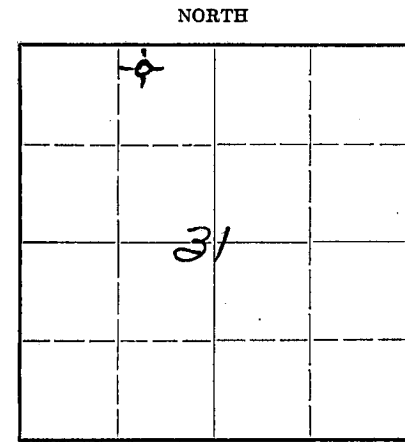

Locate well correctly on above Section Plat

Name of Conservation Agent who supervised plugging of this well **Dwight Lilly**


Producing formation Depth to top Bottom Total Depth of Well **2991** Feet

Show depth and thickness of all water, oil and gas formations.

OIL, GAS OR WATER RECORDS

CASING RECORD

Formation	Content	From	To	Size	Put In	Pulled Out
				15 1/2"	103	103
				12 1/2"	1030	1030
				10 "	1337	1337
				8 "	2628	2628
				7 "	2987	2900

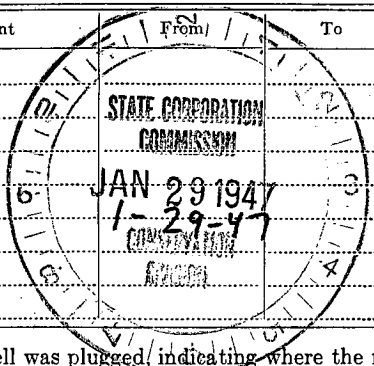

Describe in detail the manner in which the well was plugged, indicating where the mud fluid was placed and the method or methods used in introducing it into the hole. If cement or other plugs were used, state the character of same and depth placed, from feet to feet for each plug set.

Filled with mud to 150'. Set Bridge at 150' with 15 sax cement and rock. Mud to cellar. Set 5 sax cement, plug at Bottom of cellar.

PLUGGING  
FILE 31-26-2E  
BOOK PAGE 26 LINE 6

(If additional description is necessary, use BACK of this sheet)

Correspondence regarding this well should be addressed to **Beech Aircraft Corporation**  
Address **Wichita, Kansas**

STATE OF **Kansas**, COUNTY OF **Sedgwick**, SS.

**Frederic Murphy** (contractor) or (owner or operator) of the above-described well, being first duly sworn on oath, says: That I have knowledge of the facts, statements, and matters herein contained and the log of the above-described well as filed and that the same are true and correct. So help me God.

(Signature) **Frederic Murphy**

**Wichita, Kansas**  
(Address)

SUBSCRIBED AND SWORN to before me this **18th** day of **Jan**, 19 **47**



**Chester Williams**  
Notary Public.

My commission expires **Aug 19, 1950**